


**LAND CORNER RECORDATION CERTIFICATE**  
**Filing Requirement of Act 74, Mich. P.A. 1970**  
 WILLIAMSTOWN TOWNSHIP

For corners in  
INGHAM  
 (County)

Located In: \_\_\_\_\_ Corner Code # \_\_\_\_\_

**FILED**  
 950006186  
 12/12/1995 15:10:05  
 REGISTER OF DEEDS  
 Paula Johnson  
 INGHAM COUNTY, MI

- 1. Public Land Survey T 4N R 1E \_\_\_\_\_ D-12  
 T \_\_\_\_\_ R \_\_\_\_\_  
 T \_\_\_\_\_ R \_\_\_\_\_  
 T \_\_\_\_\_ R \_\_\_\_\_
- 2. Property Controlling S \_\_\_\_\_ T \_\_\_\_\_ R \_\_\_\_\_  
 in Section S \_\_\_\_\_ T \_\_\_\_\_ R \_\_\_\_\_
- 3. Miscellaneous S \_\_\_\_\_ T \_\_\_\_\_ R \_\_\_\_\_  
 Property in Sec. S \_\_\_\_\_ T \_\_\_\_\_ R \_\_\_\_\_
- 4. Lot No. \_\_\_\_\_, Recorded Plat \_\_\_\_\_
- 5. Private Claims \_\_\_\_\_

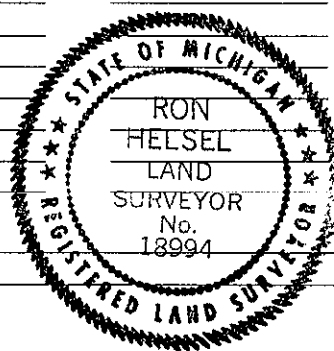

Register of Deeds Stamp & File Number

	A	B	C	D	E	F	G	H	I	J	K	L	M
2	6	5	4	3	2	1							
3													
4	7	8	9	10	11	12							
5													
6	18	17	16	15	14	13							
7													
8	19	20	21	22	23	24							
9													
10	30	29	28	27	26	25							
11													
12	31	32	33	34	35	36							
13													

I, RON HELSEL, in a field survey on NOVEMBER 21, 1995, do hereby certify that under requirements of P.A. 74, Michigan P.A. of 1970, the corner points mentioned in lines 1 and 2 above were in conformance with regulations and rules therefore as required in the current manual of survey instructions of the United States Department of the Interior, Bureau of Land Management or by a decree of a Court of Law and/or that the corner points mentioned in lines 3, 4 and 5 above were in conformance with the rules of the Michigan Board of Land Surveyors or by a Decree of a Court of Law; established, re-established, monumented, re-monumented, recovered, found as expressed below:

**NOTE: Not more than 4 corners, all in the same town and range, may be recorded on this certificate.**

**A. Description of original monument and accessories and/or subsequent restoration:**

CORNER NOT SET IN ORIGINAL GOVERNMENT SURVEY.

- 1) COUNTY SURVEYOR A. JACKSON REFERRED TO THIS CORNER IN VOL. 2, PG. 175, DEC. 22, 1853. NO MONUMENT DESCRIBED AND WITNESSED AS:  
 BEECH 16, N48E, 16 LINKS  
 MAPLE 13, N67 3/4W, 5 LINKS
- 2) COUNTY SURVEYOR, W.H. RAYNOR, WITNESSED THIS CORNER IN A SURVEY DATED JUNE 13 & 14, 1894 IN VOL. 3, PAGE 229. HIS FIELD NOTES IN DESCRIBING THE BOUNDARY, "MEASURED WEST OF THE E. POST - CENTER OF SEC. 32 180 R TO MERIDIAN" ELM 4, S76 1/2E, 46 LINKS  
 ELM 7, N26 1/4E, 71 LINKS

**B. Description of corner evidence found and/or method applied in restoring or reestablishing corner:**

FOUND DOWNED 10" WOOD ANCHOR POST IN CENTER OF A PILE OF FIELD STONES WITH REMNANTS OF FENCE LINES NORTH-SOUTH AND EAST. COMPUTATIONS OF A TRAVERSE FOUND THAT THE ROTTED REMAINS OF THE POST IN THE CENTER OF THE FIELD STONES WAS WITHIN 1' OF THE MATHEMATICAL INTERSECTION OF THE EAST-WEST AND NORTH-SOUTH 1/4 LINES. RAYNOR GAVE A CALLING OF 180 RODS TO THE MERIDIAN (WEST, 2970') MEASURED 2971.78 FEET TO CORNER A-12 AS RECORDED. ACCEPTED THE POSITION OF THE ROTTED ANCHOR POST AS A MARKER FOR THE CORNER AND SET 3/4" x 24" FORM PIN AND CAP LABELED P.A. 345, P.S. NO. 18994 IN CENTER OF POST.

**C. Description of monument for corner and accessories established to perpetuate locating the position of the corner:**

3/4" X 24" FORM PIN AND CAP  
 SET NAIL & TAG NO. 18994 NORTH SIDE 4" ASH, AZ. 70°, 7.41'  
 SET NAIL & TAG NO. 18994 EAST SIDE 12" ASH, AZ. 05°, 32.06'  
 SET NAIL & TAG NO. 18994 WEST SIDE 12" ELM, AZ. 180°, 35.68'  
 SET NAIL & TAG NO. 18994 EAST SIDE 6" ASH, AZ. 32°, 6.40'  
 MEASURED TO N 1/4 COR. 2640.80'  
 MEASURED TO S 1/4 COR. 2647.29'  
 MEASURED TO W 1/4 COR. SEC. 31 2971.78'  
 MEASURED TO E 1/4 COR. 2622.70'

Signed by Ron Helsel Date NOV. 27, 1995  
 Surveyor's Michigan License No. 18994