

LAND CORNER RECORDATION CERTIFICATE
Filing Requirement of Act 74, Mich. P.A. 1970

For corners in INGHAM (County) Located in: WILLIAMSTOWN TOWNSHIP Corner Code # ---

- 1. Public Land Survey T 4N R 1E D-13
 T --- R --- ---
 T --- R --- ---
 T --- R --- ---
- 2. Property Controlling in Section S --- T --- R ---
 S --- T --- R ---
- 3. Miscellaneous Property in Sec. S --- T --- R ---
 S --- T --- R ---

FILED
 950006184
 12/12/1995 15:10:02
 REGISTER OF DEEDS
 Paula Johnson
 INGHAM COUNTY, MI

Register of Deeds Stamp & File Number

- 4. Lot No. _____, Recorded Plat _____
- 5. Private Claims _____

	A	B	C	D	E	F	G	H	I	J	K	L
2	6	5	4	3	2	1						
3												
4	7	8	9	10	11	12						
5												
6	18	17	16	15	14	13						
7												
8	19	20	21	22	23	24						
9												
10	30	29	28	27	26	25						
11												
12	31	32	33	34	35	36						
13												

I, RON HELSEL, in a field survey on OCTOBER 18, 19 95, do hereby certify that under requirements of P.A. 74, Michigan P.A. of 1970, the corner points mentioned in lines 1 and 2 above were in conformance with regulations and rules therefore as required in the current manual of survey instructions of the United States Department of the Interior, Bureau of Land Management or by a decree of a Court of Law and/or that the corner points mentioned in lines 3, 4 and 5 above were in conformance with the rules of the Michigan Board of Land Surveyors or by a Decree of a Court of Law; established, re-established, monumented, re-monumented, recovered, found as expressed below:


NOTE: Not more than 4 corners, all in the same town and range, may be recorded on this certificate.

A. Description of original monument and accessories and/or subsequent restoration:
 ORIGINAL MONUMENT: POST SET BY J. WAMPLER, U.S. DEPUTY SURVEYOR, MARCH, 1826.
 BEECH 9" N47°W, 18 LINKS
 BEECH 7" N71°E, 34 LINKS
 1) COUNTY SURVEYOR, W.H. RAYNOR IN A SURVEY RECORDED IN LIBER 3, PAGE 229, INGHAM CO. RECORDS, DATED JUNE 13 & 14, 1894, WITNESSED THIS CORNER AS:
 BEECH 12", S44W, 8 LINKS
 BEECH 16", S28E, 14 LINKS
 ELM 6", S73E, 94 LINKS

(CONTINUED ON BACK)

B. Description of corner evidence found and/or method applied in restoring or reestablishing corner:
 FOUND STEPHENS 1/2" BAR & CAP INSIDE 1 1/2" PIPE ON EAST SIDE OF A STEEL "T" FENCE POST DRIVEN INTO REMAINS OF A ROTTED ANCHOR POST AT THE INTERSECTION OF FENCES NORTH, SOUTH, EAST AND WEST. THE STEEL POST IS RECORDED AS D-1, T3N, R1E IN LIBER 5, PAGE 149 BY A.S. PIERSON NO. 13039. RAYNOR'S SURVEY, "1-A" ABOVE, GAVE A DISTANCE OF 191 RODS, 22 LINKS FROM THIS CORNER TO A-13 ON THE PRINCIPLE MERIDIAN (3166.02') TRAVERSED AND MEASURED FROM D-13 TO A-13 3164.13 FEET. RAYNOR'S MEASUREMENT TO THE CENTER OF SEC. D-12 WAS 160 RODS (2640') MEASURED ± 2646' TO A PILE OF ROCKS AND BROKEN POST. RAYNOR'S MEASURED 180 RODS (2970') TO THE WEST 1/4 COR. OF SEC. 31 A-12 FROM D-12. TRAVERSED AND MEASURED 2971.78'. ACCEPTED STEPHENS MARKER AND LEFT INTACT. COULD'NT MOVE THE 1 1/2" PIPE.

C. Description of monument for corner and accessories established to perpetuate locating the position of the corner:
 1/2" IRON BAR & CAP #16053 INSIDE 1 1/2" PIPE
 SET NAIL & TAG #18994 SOUTH SIDE 10" W. CHERRY AZ. 95°, 57.12'
 SET NAIL & TAG #18994 EAST SIDE 12" ELM AZ. 184°, 28.17'
 SET NAIL & TAG #18994 WEST SIDE 6" CHERRY AZ. 350°, 3.74'
 SET NAIL & TAG #18994 WEST SIDE 4" ELM AZ. 20°, 16.75'
 MEASURED 2634.82' TO E-13
 MEASURED 3164.13' TO A-13
 MEASURED 2647.29' TO D-12 AS SET AND PEER APPROVED 12/7/95

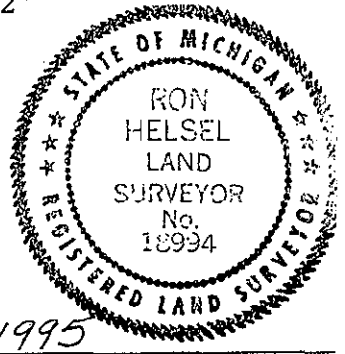

Signed by Ron Helsel Date NOV. 17, 1995
 Surveyor's Michigan License No. 18994 REVISED
 P.A. 345 INGHAM COUNTY FORM APPROVED BY MICHIGAN STATE BOARD OF LAND SURVEYORS, JAN. 28, 19
 PEER APPROVED 12/7/95 REVISED MAY 14, 19
 REVISED JAN., 19

"A" CONTINUED

2) A L.C.R.C. WAS RECORDED IN LIBER 7, PAGE 191, DATED SEPT. 13, 1990 BY J.E. STEPHENS NO. 15063. "FOUND 1 1/2" PIPE IN BASE OF 4-WAY FENCE CORNER."

- WEST SIDE 10" ELM TREE, S3°E, 28.45' (FOUND TREE)
- NORTH SIDE 8" BIRCH TREE, EAST, 17.45' (GONE)
- EAST SIDE 14" CHERRY TREE, N5°W, 24.10' (FOUND TREE)
- WEST SIDE 6" CHERRY TREE, N8°W, 3.45' (FOUND TREE)

