

LAND CORNER RECORDATION CERTIFICATE
Filing Requirement of Act 74, Mich. P.A. 1970

For corners in

INGHAM
(County)

Located In:

WILLIAMSTOWN TOWNSHIP

Corner Code #

- | | | |
|------------------------------------|-------------------------|-------------|
| 1. Public Land Survey | T <u>4N</u> R <u>1E</u> | <u>E-11</u> |
| | T _____ R _____ | _____ |
| | T _____ R _____ | _____ |
| | T _____ R _____ | _____ |
| 2. Property Controlling in Section | S _____ T _____ R _____ | _____ |
| | S _____ T _____ R _____ | _____ |
| 3. Miscellaneous Property in Sec. | S _____ T _____ R _____ | _____ |
| | S _____ T _____ R _____ | _____ |

FILED
950006185
12/12/1995 15:10:03
REGISTER OF DEEDS
Paula Johnson
INGHAM COUNTY, MI

Register of Deeds Stamp & File Number

4. Lot No. _____, Recorded Plat _____
5. Private Claims _____

A	B	C	D	E	F	G	H	I	J	K	L
2	6	5	4	3	2	1					
3											
4	7	8	9	10	11	12					
5											
6	18	17	16	15	14	13					
7											
8	19	20	21	22	23	24					
9											
10	30	29	28	27	26	25					
11											
12	31	32	33	34	35	36					
13											

I, RON HELSEL, in a field survey on NOVEMBER 27, 19 95, do hereby certify that under requirements of P.A. 74, Michigan P.A. of 1970, the corner points mentioned in lines 1 and 2 above were in conformance with regulations and rules therefore as required in the current manual of survey instructions of the United States Department of the Interior, Bureau of Land Management or by a decree of a Court of Law and/or that the corner points mentioned in lines 3, 4 and 5 above were in conformance with the rules of the Michigan Board of Land Surveyors or by a Decree of a Court of Law; established, re-established, monumented, re-monumented, recovered, found as expressed below:

NOTE: Not more than 4 corners, all in the same town and range, may be recorded on this certificate.

A. Description of original monument and accessories and/or subsequent restoration:


ORIGINAL MONUMENT: POST SET BY J. WAMPLER, U.S. DEPUTY SURVEYOR MARCH, 1826
BEECH 8" N62E, 20 LINKS
SUGAR 16" S46W, 3 1/2 LINKS

- 1) DID NOT FIND ANY COUNTY SURVEYS TIED TO THIS CORNER, HOWEVER A SURVEY BY A. JACKSON VOL. 2, PAGE 175 ON DEC. 22, 1853 IMPLIES THAT THIS CORNER WAS USED TO ESTABLISH THE WEST 1/2 OF THE NE 1/4 OF SECTION 32.
- 2) SUNNYSIDE PLAT LIBER 14, PAGE 19, 1945 REFERS TO THIS CORNER.

(CONTINUED ON BACK)

B. Description of corner evidence found and/or method applied in restoring or reestablishing corner:

FOUND 1/2" BAR AND CAP R.L.S. NO. 18998 IN MONUMENT BOX 1.0' EAST CENTERLINE BURKLEY ROAD AND 4' ± SOUTH OF CENTERLINE TURNER ROAD TO WEST. EXCAVATED 4' X 4' HOLE DOWN TO OLD CLAY ROAD BED. DID NOT FIND ANY EVIDENCE CONTRARY TO THE POSITION OF THE 1/2" BAR. ACCEPTED POSITION OF BAR AS A FAITHFUL PERPETUATION OF THIS CORNER. SET 3/4" X 24" FORM PIN & CAP LABELED P.A. 345, P.S. 18994 IN MON. BOX.

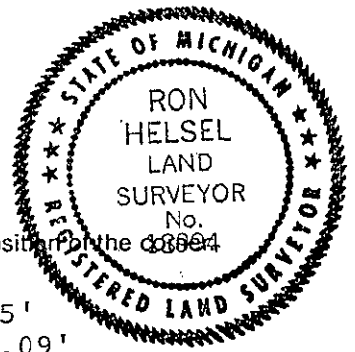

C. Description of monument for corner and accessories established to perpetuate locating the position for the corner:

3/4" FORM PIN & CAP
SET NAIL & TAG NO. 18994 SW/SIDE 10" OAK AZ. 317°, 72.05'
SET NAIL & TAG NO. 18994 SOUTH/SIDE 6" ELM AZ. 321°, 53.09'
SET NAIL & TAG NO. 18994 SOUTH/SIDE 6" CEDAR POST AZ. 37°, 43.73'
FOUND NAIL & TAG NO. 16053 W/SIDE UTILITY POLE AZ. 159°, 66.49'
SET NAIL & TAG NO. 18994 E/SIDE 10" ELM AZ. 345°, 122.99'
SE COR. FOUNDATION OLD SCHOOL HOUSE AZ. 327°, 92.88'

Signed by Ron Helsel Date NOV. 28, 1995

Surveyor's Michigan License No. 18994

"A" CONTINUED

3) A L.C.R.C. WAS RECORDED IN LIBER 2, PAGE 403, FIELD DATED MARCH 13, 1973 BY R.M. LESTER #18998 ALONG WITH A P.A. 132 SURVEY RECORDED IN LIBER 1, PAGES 731 & 732. "RE-ESTABLISHED CORNER USING RECORDED PLAT OF SUNNYSIDE PLAT AS RECORDED IN LIBER 14, PAGE 19 INGHAM COUNTY RECORDS."

SET 1/2" BAR

SE CORNER OLD SCHOOL HOUSE FOUNDATION, NW, 92.90' (FOUND)
 NAIL & TAG IN NORTH SIDE FENCE POST, SW, 33.71' (GONE)
 NAIL & TAG IN WEST SIDE 30" ASH, NNE, 133.24' (GONE)

4) A SURVEY WAS RECORDED IN LIBER 4, PAGES 1087 & 1088, MAY 15, 1985 BY M.F. FOUTY #18989. HE CITED SAME WITNESSES AS L.C.R.C. ABOVE.

5) A L.C.R.C. WAS RECORDED IN LIBER 7, PAGE 192, DATED SEPT. 13, 1990 BY J.E. STEPHENS NO. 16053, "TO UPDATE WITNESS INFORMATION".

1/2" BAR

SE COR. OF OLD SCHOOL HOUSE FOUNDATION NW, 92.90' (FOUND)
 BASE OF STOP SIGN S10°W, 35.95' (FOUND)
 SURVEY TAG NO. 25832 NAILED TO WEST SIDE UTILITY POLE
 S20°E, 66.45' (FOUND POLE)
 SURVEY TAG NO. 25832 NAILED TO WEST SIDE 6" MAPLE,
 N45°W, 72.30' (FOUND OAK IN THIS POSITION)

INGHAM COUNTY
 REGISTERED
 DEPT. OF LAND & WATER
 1000 N. B. ST.
 LANSING, MI 48201