

DEC 14 1993

COMMISSION

LAND CORNER RECORDATION CERTIFICATE  
Filing Requirement of Act 74, Mich. P.A. 1970

LIBER 8 PAGE 59

FILED

For corners in

INGHAM  
(County)

Located In:

Corner Code #

- 1. Public Land Survey      T 4N R 1E      F-1  
                                   T \_\_\_\_\_ R \_\_\_\_\_  
                                   T \_\_\_\_\_ R \_\_\_\_\_  
                                   T \_\_\_\_\_ R \_\_\_\_\_
- 2. Property Controlling      S \_\_\_\_\_ T \_\_\_\_\_ R \_\_\_\_\_  
    in Section                S \_\_\_\_\_ T \_\_\_\_\_ R \_\_\_\_\_
- 3. Miscellaneous            S \_\_\_\_\_ T \_\_\_\_\_ R \_\_\_\_\_  
    Property in Sec.         S \_\_\_\_\_ T \_\_\_\_\_ R \_\_\_\_\_

DEC 29 31 AM '93

REGISTER OF DEEDS  
*Paula Johnson*  
INGHAM COUNTY, MICH.

Register of Deeds Stamp & File Number

- 4. Lot No. \_\_\_\_\_, Recorded Plat \_\_\_\_\_
- 5. Private Claims \_\_\_\_\_

	A	B	C	D	E	F	G	H	I	J	K	L	M
2	6	5	4	3	2	1							
3													
4	7	8	9	10	11	12							
5													
6	16	17	16	15	14	13							
7													
8	19	20	21	22	23	24							
9													
10	30	29	28	27	26	25							
11													
12	31	32	33	34	35	36							
13													

I, Marvin Fouty, in a field survey on Aug. 7, 19 93, do hereby certify that under requirements of P.A. 74, Michigan P.A. of 1970, the corner points mentioned in lines 1 and 2 above were in conformance with regulations and rules therefore as required in the current manual of survey instructions of the United States Department of the Interior, Bureau of Land Management or by a decree of a Court of Law and/or that the corner points mentioned in lines 3, 4 and 5 above were in conformance with the rules of the Michigan Board of Land Surveyors or by a Decree of a Court of Law; established, re-established, monumented, re-monumented, recovered, found as expressed below:

NOTE: Not more than 4 corners, all in the same town and range, may be recorded on this certificate.

A. Description of original monument and accessories and/or subsequent restoration:

1. Post not set in original Government Survey.

2. Anson Jackson, County Surveyor, reported using the corner in a survey dated June 1843 and recorded in Vol 1 Page 190 Ingham County Surveyors Records with the following witnesses:

- R. Oak 18 S11 1/2E 17 (11.2')
- Y. Oak 12 N26 1/4E 15 (9.9')

(Continued on Back)\*


B. Description of corner evidence found and/or method applied in restoring or reestablishing corner:

Searched at probable location of the corner from witnesses in items (A) 6 and 7 and found a 1/2" iron pipe in monument box. The corner lies on a small hill that has a 3' to 5' cut section according to long time area residents. Accepted the pipe as corner location as best available evidence.

Field work conducted by David Clifford, PS No. 25837

C. Description of monument for corner and accessories established to perpetuate locating the position of the corner:

- 1/2" pipe with cap #11370 (Steadman) in monument box..
- Set Nail & Tag #25837 in 32" Oak Az 187°
- Found Stephens tag in Power Pole Az 306° 103.11'
- Found Nail & Tag #11370 in Tel. Pole Az. 142°47.50'
- Set Nail & Tag #25837 in 22" Cherry Az. 104° 84.00'
- SW corner house foundation Az. 33° 84.40'
- Found 1 1/4" iron rod at SE cor. Sec. 33, T5N, R1E, Az. 270° 155.76'

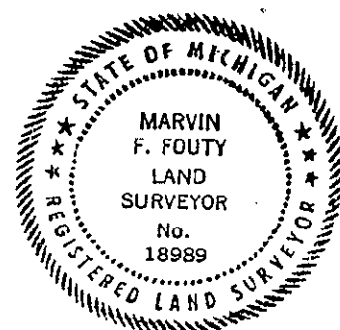

Signed by Marvin Fouty Date Nov. 20, 1993  
Surveyor's Michigan License No. 18989

3. A. P. Drake, County Surveyor, found and used Jackson's corner and setting a new post in a survey dated March 1879 and recorded in Vol 3, Page 143, Ingham County Surveyor Records
4. Surveyor Richard Steadman LS # 11370 reported using the corner on Nov. 29, 1976 and recorded in Liber 2 of Surveys, Page 944 with the same monument and witnesses as in item 6 below:
5. Surveyor Steadman again reported using the corner on March 16, 1978 and recorded in Liber 3 of Surveys, Page 272 with the same monument and witnesses as in item 6 below:
6. Surveyor recorded the corner on Dec. 20, 1978 in Liber 5 of corners, Page 95 as a set 3/4" iron rod in the center of Foster Road on line with corresponding corners for T5N, R1E as called for in a 1961 survey by John Quine, RLS with the following witnesses:  
20" Wild Cherry S76°E 83.57'  
Telephone Pole S40°E 47.50'  
26" Oak S10°W 88.58'  
SW Cor. Hse Foundation N26°E 84.80'
7. Surveyor James Porter LS # 19003 recorded the corner on Aug 28, 1978 in Liber 4 of Corners Page 384 as a found 1/2" pipe and cap # 11370 in monument box with the following witnesses:  
Found Stephens Eng Tag in Power Pole N45°W 103.11'  
Found Stephens Eng Tag in 36" Oak S10°W 88.58'  
Found Stephens Eng Tag in Telephone Pole S45°E 47.50'  
Emery & Porter Tag in 20" Wild Cherry S80°E 83.83'
8. Surveyor Larry Bryan LS # 25832 reported using the corner in Aug. 1990 and recorded in Liber 6 of Surveys, Page 340 as a found 1/2" bar in monument box with the same witnesses as in item 6 above.