

DEC 14 1993

COMMISSION

LIBER 8 PAGE 65

LAND CORNER RECORDATION CERTIFICATE  
Filing Requirement of Act 74, Mich. P.A. 1970

FILED

For corners in

<u>INGHAM</u> (County)	Located In:	Corner Code #
1. Public Land Survey	T <u>4N</u> R <u>1E</u>	<u>F-5</u>
	T _____ R _____	_____
	T _____ R _____	_____
	T _____ R _____	_____
2. Property Controlling in Section	S _____ T _____ R _____	_____
	S _____ T _____ R _____	_____
3. Miscellaneous Property in Sec.	S _____ T _____ R _____	_____
	S _____ T _____ R _____	_____

DEC 29 33 AM '93

REGISTERED DEEDS  
*Paul Johnson*  
INGHAM COUNTY, MICH.

Register of Deeds Stamp & File Number

- 4. Lot No. \_\_\_\_\_, Recorded Plat \_\_\_\_\_
- 5. Private Claims \_\_\_\_\_

A	B	C	D	E	F	G	H	I	J	K	L	M
2	6	5	4	3	2	1						
3												
4	7	8	9	10	11	12						
5												
6	10	17	16	15	14	13						
7												
8	19	20	21	22	23	24						
9												
10	30	29	28	27	26	25						
11												
12	31	32	33	34	35	36						
13												

I, Marvin Fouty, in a field survey on August 7, 19 93, do hereby certify that under requirements of P.A. 74, Michigan P.A. of 1970, the corner points mentioned in lines 1 and 2 above were in conformance with regulations and rules therefore as required in the current manual of survey instructions of the United States Department of the Interior, Bureau of Land Management or by a decree of a Court of Law and/or that the corner points mentioned in lines 3, 4 and 5 above were in conformance with the rules of the Michigan Board of Land Surveyors or by a Decree of a Court of Law; established, re-established, monumented, re-monumented, recovered, found as expressed below:

NOTE: Not more than 4 corners, all in the same town and range, may be recorded on this certificate.

A. Description of original monument and accessories and/or subsequent restoration:

1. Post set in original government survey by Joseph Wampler D.S. in March 1826 with the following Witnesses:  
W. Oak S52E 19 1/2 (12.9')  
Hick S70°W 33 1/2 (22.1)

2. A.P. Drake County Surveyor reported using the corner in a survey dated March 1879 and recorded in Volume 3 page 143 Ingham County Surveyor's Records as a stone with the following witnesses:  
Hickory 6" S33 3/4°W 47 1/2 lks (31.35')  
Hickory 8" S75 1/4°W 123 1/2 lks (81.5') (Continued on Back)


B. Description of corner evidence found and/or method applied in restoring or reestablishing corner:

Searched at apparent location of corner and found boat spike in Monument box matching, A.P. Drakes witnesses of 1879 (Both hickories still standing) and matching preceding witnesses of present day surveyors. Excavated bottom of Monument box and found stone under boat spike in West edge of box. Accepted stone as corner as described by Drake in 1879 and used by all present day surveyors. Replaced boat spike with standard bar.

Field work conducted by David Clifford, PS No. 25837

C. Description of monument for corner and accessories established to perpetuate locating the position of the corner:

Standard 3/4" x 24" Ingham County Remonumentation bar & PA345 cap #18989 0.15' East of top of stone in monument box  
Stephens Engineering Tag in power pole AZ; 353° 32.35'  
Stephens Engineering Tag in 21" Hickory AZ; 255° 82.35'  
Stephens Engineering Tag in 21" Hickory AZ; 214° 32.55'  
NE Corner of Brick School House Building AZ 224° 94.75'

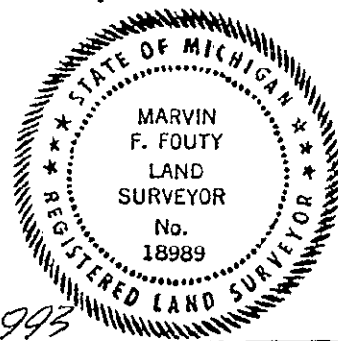

Signed by *Marvin Fouty* Date Nov. 19, 1993  
Surveyor's Michigan License No. 18989

3. Clyde Stephens LS #3829 recorded the corner on June 10, 1971 in Liber 1 of corners Page 21 as a found boat spike with the following witnesses:  
Stephens Engineering tag in power pole N6°48'W, 32.53'  
Stephens Engineering tag in 20" Hickory S74°44'W, 82.12'  
Stephens Engineering tag in 24" Hickory S30°09'W, 32.37'
4. Clyde Stephens reported using corner in a survey on May 18, 1971 and recorded in Liber 1 of surveys Page 8, Ingham County records with the same monument and witnesses as in item 3 above.
5. Ron Helsel LS#18994 recorded the corner on Nov. 9, 1973 in Liber 2 of corners Page 541, Ingham County Records as a found 1/2" boat spike with the following witnesses:  
N & T NW Side 18" Hickory S30°W 32.37'  
N & T W Side Power Pole N03°W 32.49'  
N & T Corner brick school house S40°W 94.70'
6. Marvin Fouty LS #18989 reported using the corner in a survey on Nov. 17, 1977 with same monument and witnesses as in item 3 above.
7. James Stephens LS #16053 reported using the corner in surveys on Jan 11, 1980 and recorded in Liber 3 of surveys pages 1138, 1140, 1200, 1202, 1204 & 1206 as a found boat spike with the same monument and witnesses as in item 3 above.