

DEC 14 1993

COMMISSION

LIBER 8 PAGE 61

FILED

LAND CORNER RECORDATION CERTIFICATE
Filing Requirement of Act 74, Mich. P.A. 1970

For corners in

INGHAM
(County)

Located In:

Corner Code #

- 1. Public Land Survey T 4N R 1E G-2
 T _____ R _____
 T _____ R _____
 T _____ R _____
- 2. Property Controlling S _____ T _____ R _____
 in Section S _____ T _____ R _____
- 3. Miscellaneous S _____ T _____ R _____
 Property in Sec. S _____ T _____ R _____
- 4. Lot No. _____, Recorded Plat _____
- 5. Private Claims _____

DEC 29 32 AM '93

REGISTER OF DEEDS
David Johnson
INGHAM COUNTY, MICH.

Register of Deeds Stamp & File Number

I, Marvin Fouty, in a field survey on September 4, 19 93, do hereby certify that under requirements of P.A. 74, Michigan P.A. of 1970, the corner points mentioned in lines 1 and 2 above were in conformance with regulations and rules therefore as required in the current manual of survey instructions of the United States Department of the Interior, Bureau of Land Management or by a decree of a Court of Law and/or that the corner points mentioned in lines 3, 4 and 5 above were in conformance with the rules of the Michigan Board of Land Surveyors or by a Decree of a Court of Law, established, re-established, monumented, re-monumented, recovered, found as expressed below:

| | | | | | | | | | | | | |
|----|----|----|----|----|----|----|---|---|---|---|---|---|
| A | B | C | D | E | F | G | H | I | J | K | L | M |
| 2 | 6 | 5 | 4 | 3 | 2 | 1 | | | | | | |
| 3 | | | | | | | | | | | | |
| 4 | 7 | 8 | 9 | 10 | 11 | 12 | | | | | | |
| 5 | | | | | | | | | | | | |
| 6 | 16 | 17 | 18 | 15 | 14 | 13 | | | | | | |
| 7 | | | | | | | | | | | | |
| 8 | 19 | 20 | 21 | 22 | 23 | 24 | | | | | | |
| 9 | | | | | | | | | | | | |
| 10 | 30 | 29 | 28 | 27 | 26 | 25 | | | | | | |
| 11 | | | | | | | | | | | | |
| 12 | 31 | 32 | 33 | 34 | 35 | 36 | | | | | | |
| 13 | | | | | | | | | | | | |

NOTE: Not more than 4 corners, all in the same town and range, may be recorded on this certificate.

A. Description of original monument and accessories and/or subsequent restoration:

1. Post set in original Government Survey by Joseph Wampler D.S. in March 1826 with the following witnesses:
Aspen 6 N64W (undecipherable)
Elm 14 S11W 40 (26.4)

2. A. Jackson, County Surveyor, reported using the corner in a survey dated January, 1947 and recorded in Volume 2, Page 8, Ingham County Surveyor's Records with no mention of monument and the following witnesses:
W. Oak 17 N42W 46 (30.36')
do 14 S56W 5 (3.3)' (Continued on Back)


B. Description of corner evidence found and/or method applied in restoring or reestablishing corner:

Searched at probable location of the corner and found a "T" iron at East side of a 12" fence post (fences run North, South & West). Excavated around the "T" iron and found highly magnetic (mostly iron) stone and 2" x 2" x 12" white brick. Accepted corner post, "T" iron, brick & stone as corner as perpetuated by A. Jackson & A.P. Drake and set standard 3/4" bar & cap next to "T" iron.

Field work conducted by David Clifford, PS No. 25837

C. Description of monument for corner and accessories established to perpetuate locating the position of the corner:

Standard 3/4" x 24" Ingham County Remonumentation bar & PA 345 Cap #18989
Set Nail & Tag #25837 in East side 40" Ash AZ 214° 35.30'
Set Nail & Tag #25837 in West side 36" Ash AZ 128° 18.85'
Set Nail & Tag #25837 in SE side 36" Ash AZ 235° 2.15'
Set Nail & Tag 25837 in West side 6" Maple AZ 64° 13.99'
Found Nail & Tag #25837 in West side 8" Ash AZ 35° 31.45'

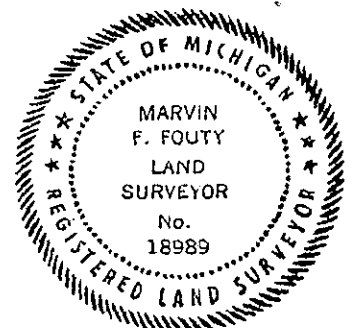

Signed by Marvin Fouty Date Nov. 19, 1993
Surveyor's Michigan License No. 18989

3. A.P. Drake, County Surveyor, reported using the corner in a survey dated March 1879 and recorded in Vol 3 Page 143, Ingham County Surveyor Records as a post from which bears:
B. Ash 14 S11W 40 (26.4')
W.O. 24 N64°W 85 (56.1')
4. Gary Lester LS #17624 recorded the corner on August 26, 1971 in Liber 1 of Corners, Page 147 as a "T" Iron set at a fence corner post with the following witnesses:
Nail & Tag in 10" Ash SW 21.55
Nail & Tag in fence post West 11.17
Nail & Tag in 10" Ash NW 27.65
5. Surveyor Ron Helsel LS # 18994 reported using the corner July, 1976 in surveys recorded in Liber 2 of Surveys, Pages 905-908 with no description and labeled (Liber 1, Page 147)
6. Surveyor Doug Richardson LS # 31603 reported using the corner in July, 1988 in surveys recorded in Liber 5 of Surveys, Pages 555 with no description and labeled (Liber 1, Page 147)
7. Larry Bryan LS #25832 reported using the corner in a survey on July 9, 1992 as a "T" bar at East edge 3 way fence corner with the following witnesses:
Nail and Tag #25832 West side 14" Ash N10°E 31.50'
Nail and Tag #25832 East side 14" Ash S05°W
Nail & Tag #17624 North side 14" Ash S80°W 21.43'