

DEC 14 1993

LIBER 8 PAGE 71

COMMISSION LAND CORNER RECORDATION CERTIFICATE
Filing Requirement of Act 74, Mich. P.A. 1970

FILED

For corners in

INGHAM
(County)

Located In:

Corner Code ##

- 1. Public Land Survey T 4N R 1E G-3
T _____ R _____
T _____ R _____
T _____ R _____
- 2. Property Controlling S _____ T _____ R _____
in Section S _____ T _____ R _____
- 3. Miscellaneous S _____ T _____ R _____
Property in Sec. S _____ T _____ R _____

DEC 29 33 AM '93

REGISTER OF DEEDS
David Johnson
INGHAM COUNTY, MICH.

Register of Deeds Stamp & File Number

- 4. Lot No. _____, Recorded Plat _____
- 5. Private Claims _____

	A	B	C	D	E	F	G	H	I	J	K	L	M
2	6	5	4	3	2	1							
3							●						
4	7	8	9	10	11	12							
5													
6	18	17	16	15	14	13							
7													
8	19	20	21	22	23	24							
9													
10	30	29	28	27	26	25							
11													
12	31	32	33	34	35	36							
13													

I, Marvin Fouty, in a field survey on September 11, 19 93, do hereby certify that under requirements of P.A. 74, Michigan P.A. of 1970, the corner points mentioned in lines 1 and 2 above were in conformance with regulations and rules therelore as required in the current manual of survey instructions of the United States Department of the Interior, Bureau of Land Management or by a decree of a Court of Law and/or that the corner points mentioned in lines 3, 4 and 5 above were in conformance with the rules of the Michigan Board of Land Surveyors or by a Decree of a Court of Law; established, re-established, monumented, re-monumented, recovered, found as expressed below:

NOTE: Not more than 4 corners, all in the same town and range, may be recorded on this certificate.

A. Description of original monument and accessories and/or subsequent restoration:

- 1. Post set in original Government Survey by Joseph Wampler D.S. in April 1826 with the following witnesses:
W Oak 12" S26 1/2W (23) (15.2')
W. Oak 18" S67 1/2W 24 (15.8')

2. A.P. Drake, County Surveyor reported using the corner in a survey dated March 1879 and recorded in Liber 3, Page 143 Ingham County Surveyor's Records as a set stone with no mention of witnesses.

(Continued on Back)


B. Description of corner evidence found and/or method applied in restoring or reestablishing corner:

Searched at probable location of corner and found 1/2" Pipe with nail in center using Jim Stephen's and Ron Helsel's witnesses. Excavated around the iron pipe and 2' deep under pipe found 6" x 2' stone lying on its side and concluded that the monument was the one set by Drake. Removed stone and set standard bar & cap at location of found iron pipe.

Field work conducted by David Clifford, PS No. 25837

C. Description of monument for corner and accessories established to perpetuate locating the position of the corner:

Standard 3/4" x 24" Ingham County Remonumentation bar & PA345 cap #18989 in monument box on Centerline Gulick road and fence line North & South,
Found Nail and Tag #18989 in R.R. tie fen post AZ 218°, 25.35'
Found Nail and Tag in West side telephone pole AZ 48°, 44.25'
NE corner frame shed AZ 162°, 67.35'
Found old remon tag in East side anchor post AZ 176°, 20.93'
NW corner house foundation #1004, AZ 122°, 90.35'

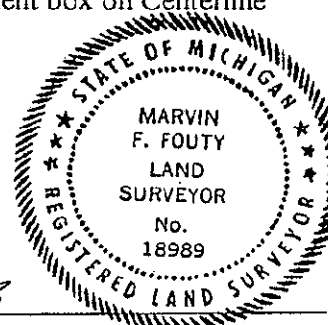

Signed by Marvin Fouty
Surveyor's Michigan License No. 18989

Date NOV. 19, 1993

3. Surveyor James Stephens LS #16053 recorded the corner on June 7, 1971 in Liber 1 of Corners, Page 13 as a found boat spike with the following witnesses:
 N55°56'W, 46.3 to a 24" Apple tree with a Stephens Engineering tag
 Stephens Engineering tag in Power pole N48°14'E, 44.2'
 Stephens Engineering tag in 16" Elm S80°37'E 134.85'
4. Surveyor Stephens reported using the corner in a survey dated May 18, 1971 and recorded in Liber 1 Page 7 with the same monument and witnesses as in item 3 above.
5. Surveyor Ron Helsel LS#18994 reported using the corner on Nov. 9, 1973 in Liber 2 of Corners, Page 543 Ingham Co. Rec. as a found 1/4" boat spike in the physical centerline of Gulick Road with the following witnesses:
 P.K. nail East side wood anchor post South 20.97'
 Nail & Tag South side 20" Apple N45°W 47.47'
 Nail & Tag West side telephone pole N40°E 44.25
6. Surveyor Helsel reported using the corner in a survey dated March 27, 1974 with the same monuments and witnesses as in item 5 above.
7. Surveyor Ron Lester LS #18998 reported using the corner in a survey dated March 1, 1974 and recorded in Liber 1 of Surveys Page 1185 with the same monument and witnesses as in item 5 above.
8. Surveyor Helsel reported again using the corner in a survey dated Feb. 2, 1976 and recorded in Liber 2 of Surveys, Page 650 with the same monuments and witnesses as in item 5 above and recorded in Liber 2, Page 543.
9. Surveyor Doug Richardson LS # 31603 reported using the corner in July, 1988 in surveys recorded in Liber 5 of Surveys, Pages 555 with no description and labeled (Liber 2, Page 543)
10. Surveyor Marvin Fouty LS #18989 reported using the corner in a survey dated Sept. 8, 1977 and recorded in Liber 3 of Surveys, Page 37 with the same monument and witnesses as in item 5 above.
11. Surveyor Robert Crampton LS #24591 reported using the corner in a survey dated June 16, 1978 and recorded in Liber 3 of surveys Page 573 Ingham County Records as a 1/2" iron pipe found with the same witnesses as in item 5 above.
12. Surveyor Fouty again reported using the corner in a survey dated February 24, 1981 and recorded in Liber 4 of Surveys Page 307 Ingham County Records as a found iron pipe found with a reference to item 5 above.
13. Surveyor Fouty again reported using the corner in a survey dated June 12, 1987 and recorded in Liber 5 Page of Surveys Page 262 with a reference to item 5 above.
14. Surveyor Richardson again reported using the corner in November, 1988 in surveys recorded in Liber 5 of Surveys, Pages 1208 with no description and labeled (Liber 2, Page 543)