

DEC 14 1993

COMMISSION

LIBER 8 PAGE 73

LAND CORNER RECORDATION CERTIFICATE
Filing Requirement of Act 74, Mich. P.A. 1970

FILED

For corners in

INGHAM (County)

Located In:

Corner Code #

1. Public Land Survey

T 4N R 1E

G-4

2. Property Controlling in Section

S T R

3. Miscellaneous Property in Sec.

S T R

DEC 29 34 AM '93

REGISTER OF DEEDS
Dennis Johnson
INGHAM COUNTY, MICH.

Register of Deeds Stamp & File Number

4. Lot No. , Recorded Plat
5. Private Claims

Grid table with columns A-M and rows 1-13. A dot is marked at the intersection of column G and row 4.

1. Marvin Fouty, in a field survey on September 4, 1993, do hereby certify that under requirements of P.A. 74, Michigan P.A. of 1970, the corner points mentioned in lines 1 and 2 above were in conformance with regulations and rules therefore as required in the current manual of survey instructions of the United States Department of the Interior, Bureau of Land Management or by a decree of a Court of Law and/or that the corner points mentioned in lines 3, 4 and 5 above were in conformance with the rules of the Michigan Board of Land Surveyors or by a Decree of a Court of Law; established, re-established, monumented, re-monumented, recovered, found as expressed below:

NOTE: Not more than 4 corners, all in the same town and range, may be recorded on this certificate.

A. Description of original monument and accessories and/or subsequent restoration:

- 1. Post set in original Government Survey by Joseph Wampler D.S. in March 1826 with the following witnesses: B Oak 32 S27W 36 (23.8') Aspen 18 N78E 54 (35.6')
2. A.P. Drake, County Surveyor reported seeing a stone at the corner in a survey dated March 1879 and recorded in Vol 3 Page 143 Ingham County Surveyors Records.

(Continued on Back)


B. Description of corner evidence found and/or method applied in restoring or reestablishing corner:

Searched at probable location of the corner and found a 1/2" bar with cap #18998 at North side of a 4 way fence corner matching witnesses from items 3 and 7 above. Excavated around the iron and found a 15 lb. stone with two bricks beneath it at North side of iron. Accepted stone as the corner set by Drake in 1879. Replaced 1/2" Bar & Cap with standard bar & cap.

Field work conducted by David Clifford, PS No. 25837

C. Description of monument for corner and accessories established to perpetuate locating the position of the corner:

- Standard 3/4" x 24" bar & PA345 cap #18989 beside stone & 4 way fence corner.
Nail & Tag #25837 East Side 6" Hickory AZ 311° 16.15'
Nail & Tag #25837 South side 28" Oak AZ 90° 19.38'
Nail & Tag #25837 East side 20" Oak AZ 0° 6.72'
Nail & Tag #25837 SE side 6" Cherry AZ 54° 7.23'

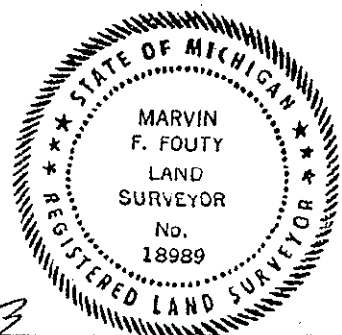

Signed by Marvin Fouty
Surveyor's Michigan License No. 18989

Date Nov. 20, 1993

3. Surveyor Ron Lester LS #18998 recorded the corner on May 7, 1974 in Liber 3 of Corners, Page 67 as a set 1/2" bar at the intersection of fences North, South, East and West with the following witnesses:
Nail & Tag NE side 6" Hickory NW 16.04'
Nail & Tag East side 18" Oak North 6.69'
Nail & Tag North side 24" Oak East 19.92'
4. Surveyor Lester reported using the corner in a survey on March 1, 1974 and recorded in Liber 1 of Surveys, Page 1185 Ingham County Records as a 1/2" bar & cap with the same witnesses as in item 3 above.
5. Surveyor Marvin Fouty LS #18989 reported using the corner on Nov. 17, 1977 in a survey recorded in Liber 3 of Surveys, Page 566 Ingham County Records with the same monument and witnesses as in item 3 above.
6. Surveyor Austin Williams LS #21275 reported using the corner in May of 1979 in a survey recorded in Liber 3 of Surveys, Page 954 Ingham County Records with no description of the monument and witnesses:
Nail in 2" Oak North 22.65'
Nail in 12" Oak SSE 23.44'
Nail in 5" Oak South 25.38'
7. Surveyor Fouty again reported using the corner in a survey on Feb. 24, 1981 and recorded in Liber 4 of Surveys, Page 307 with a reference to Liber 3 of corners Page 67 (item 3 above).
8. Surveyor Fred White LS #12034 recorded the corner on Oct. 13, 1981 in Liber 6 of Corners, Page 207 as a found 1/2" bar with cap #18998 at an anchor post with the following witnesses:
Nail & Tag in East side 20" Ash N. 6.64'
Nail & Tag in South side 20" Oak East 19.41'
Nail & Tag in NE side 18" Hickory N55°W 16.11'
9. Surveyor Fouty again reported using the corner in a survey on June 12, 1987 and recorded in Liber 5 of Surveys, Page 262 with a reference to Liber 6 of Corners Page 207 (item 7 above).