

**SURVEY & MONUMENTATION**

JAN 18 2001

Paula Johnson  
INGHAM COUNTY  
REGISTER OF DEEDS  
RON HELSEL

L-9 P-579

RECORDED  
CRNR 9.00

2000-043482

**SECTION**

**LAND CORNER RECORDATION CERTIFICATE**  
**Filing Requirement of Act 74, Mich. P.A. 1970**  
**WILLIAMSTOWN TOWNSHIP**

For corners in

<u>Ingham</u>	Located In:	Corner Code #
(County)		
1. Public Land Survey	T <u>4N</u> R <u>1E</u>	<u>G-11</u>
	T ___ R ___	_____
	T ___ R ___	_____
	T ___ R ___	_____
2. Property Controlling in Section	S ___ T ___ R ___	_____
	S ___ T ___ R ___	_____
3. Miscellaneous Property in Sec.	S ___ T ___ R ___	_____



Register of Deeds Stamp & File Number

4. Lot No. \_\_\_\_\_, Recorded Plat \_\_\_\_\_  
5. Private Claims \_\_\_\_\_

I, RON HELSEL, in a field survey on AUG. 1, 2000 do hereby state that under requirements of P.A. 74, Michigan P.A. of 1970, the corner points mentioned in lines 1 and 2 above were in conformance with regulations and rules therefore as required in the current manual of survey instructions of the United States Department of the Interior, Bureau of Land Management or by a decree of a Court of Law and /or that the corner points mentioned in lines 3, 4 and 5 above were in conformance with the rules of the Michigan Board of Land Surveyors or by a Decree of a Court of Law; established, re-established, monumented, recovered, found as expressed below:

A	B	C	D	E	F	G	H	I	J	K	L
1											
2	6		5		4		3		2		1
3											
4	7		8		9		10		11		12
5											
6	18		17		16		15		14		13
7											
8	19		20		21		22		23		24
9											
10	30		29		28		27		26		25
11											
12	31		32		33		34		35		36
13											

NOTE: Not more than 2 corners, all in the same town and range, may be recorded on this certificate.

A. Description of original monument and accessories and/or subsequent restoration:  
ORIGINAL MONUMENT: POST SET BY J. WAMPLER, US DEPUTY SURVEYOR, 1826.  
BEECH 11", N60E, 19 LINKS; BEECH 8", N63-1/2W, 20 LINKS.


WEST BETWEEN 28 & 33, 40.13 TO 1/4 POST. EAST BETWEEN 27 & 34 80.30 TO POST AT SECTION. 26, 27, 34 & 35.

DID NOT FIND ANY PUBLIC RECORDS OF COUNTY SURVEYOR ACTIVITY IN THIS AREA.

- 1) LIBER 5, PAGE 14, L.C.R.C., FIELD DATED NOV. 1, 1972 AND RECORDED OCT. 8, 1978 BY OSCAR BOSS, NO. 13574. "SET 3/8" IRON SET AT INTERSECTION OF FENCES (N-S-E-W)" NAIL E/S 6" TREE N24°W 7.27'; NAIL S/S 8" TREE N80°W 8.54'; NAIL NW/S 6" TREE N50°E 3.93'. THESE MATCH THE WITNESSES ON THE BOSS SURVEY RECORDED IN LIBER 1, PAGES 559-560 DEC. 28, 1972. BOSS RECORDED MEASUREMENTS OF S04°20'50"E, 2625. 73 FEET TO G-12 & WEST, 2645. 42 FEET TO F-11 (GLO 2648.58')
- 2) P.A. 132 SURVEY, LIBER 4, PAGE 1218-1219, APRIL 22, 1986, BY J. WILCOX NO. 14102 DID NOT IDENTIFY OR WITNESS THIS CORNER.
- 3) P.A. 132 SURVEY, LIBER 4, PAGE 1220-1221, APRIL 23, 1986, BY JACK OWENS NO. 20709, GAVE THE SAME WITNESSES AS 1-A ABOVE.
- 4) UNRECORDED SURVEYS BY M. FOUTY NO. 18989 DATED 10-04-91 & 10-08-93. "FOUND 3/8" IRON" NO WITNESSES WERE GIVEN. BOTH SURVEYS MEASURED S03°24'40"E, 2626.53 FEET TO G-12 (EAST 1/4 CORNER).

B. Description of corner evidence found and/or method applied in restoring or reestablishing corner:  
FOUND A 3/8" IRON BAR AT THE INTERSECTION OF A 4 WAY FENCE LINE 6" ABOVE A CIRCLE OF FIELD STONES AROUND OF WHERE AN APPARENT ANCHOR POST HAD BEEN. EXCAVATED DOWN ABOUT 24" THROUGH THE STONES BUT DID NOT FIND ANY EVIDENCE OF A PREVIOUS CORNER. ACCEPTED THE POSITION OF THE BOSS MARKER AS FAITHFUL PERPETUATION OF THE CORNER AND SET A STANDARD 3/4" X 24" FORM PIN AND INGHAM COUNTY DISK STAMPED P.A. 345, P.S. 18994 AT THAT POSITION. FOUND A 10" ASH AND NAIL AS THE ONLY REMAINING WITNESS TREE.

C. Description of monument for corner and accessories established to perpetuate locating the position of the corner:  
3/4" IRON PIN AND INGHAM COUNTY DISK AT INTERSECTION OF FENCES.  
SET NAIL & TAG NO. 18994 NE/SIDE 6" ASH, N. AZ. 280°, 2.62 FEET  
SET NAIL & TAG NO. 18994 ABOVE A NAIL NE/SIDE 10" ASH, N. AZ. 336°, 7.30 FEET  
SET NAIL & TAG NO. 18994 NW/SIDE 20" MAPLE, N. AZ. 100°, 26.90 FEET  
SET NAIL & TAG NO. 18994 NW/SIDE 8" ASH, N. AZ. 180°, 16.05 FEET

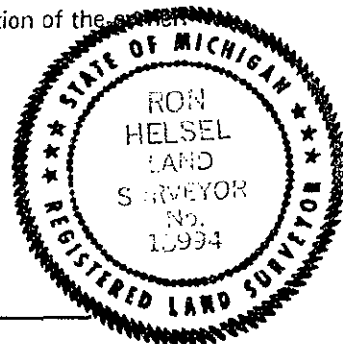

Signed by Ron Helsel  
Surveyor's Michigan License No. 18994

Date 9-14-00

FORM APPROVED BY MICHIGAN STATE BOARD OF PROFESSIONAL SURVEYORS, JAN. 28, 1971  
REVISED MAY 14, 1975  
REVISED JAN., 1983  
REVISED OCT., 1955

P.A. 345 INGHAM COUNTY  
PEER APPROVED 9/7/2000 RL