

SURVEY & REMONUMENTATION

SECTION _____

LAND CORNER RECORDATION CERTIFICATE
 Filing Requirement of Act 74, Mich. P.A. 1970

1 of corners in
INGHAM
 (County)

Located In:

Corner Code # _____

Paula Johnson
 INGHAM COUNTY
 REGISTER OF DEEDS RECORDED
 SUNDBERG CARLSON & ASSOCIAT CRNR 11.00

L-9 P-513

1999-053019

MERIDIAN TWP.
 1 Public Land Survey

T 4N R 1W

G-11

T	R
T	R
T	R
S	T
S	T
S	T
S	T



Register of Deeds Stamp & File Number

4. Lot No. _____ Recorded Plat _____
 5. Private Claims _____

I, DAVID R. LOHR, in a field survey on AUGUST 30, 1999, do hereby certify that under requirements of P.A. 74, Michigan P.A. of 1970, the corner points mentioned in lines 1 and 2 above were in conformance with regulations and rules therefore as required in the current manual of survey instructions of the United States Department of the Interior, Bureau of Land Management or by a decree of a Court of Law and/or that the corner points mentioned in lines 3, 4 and 5 above were in conformance with the rules of the Michigan Board of Land Surveyors or by a Decree of a Court of Law; established, re-established, monumented, re-monumented, recovered, found as expressed below.

NOTE: Not more than 2 corners, all in the same town and range, may be recorded on this certificate.

	A	B	C	D	E	F	G	H	I	J	K	L	M
1													
2	6	5						3	2	1			
3													
4	7	8	9	10	11	12							
5													
6	18	17	16	15	14	13							
7													
8	19	20	21	22	23	24							
9													
10	30	29	28	27	26	25							
11													
12	31	32	33	34	35	36							
13													


A. Description of original monument and accessories and/or subsequent restoration:
 1. CORNER SET BY LUCIUS LYON, U.S. DEPUTY SURVEYOR IN JANUARY OF 1827. "NORTH BETWEEN SECTIONS 33 & 34." AT DISTANCE OF 40.00 CH(2640.0') "SET POST COR. SECS. 27, 28, 33 & 34 fw" WITNESSED BY:
 BE 10", S 13° E, 22 LKS. (14.52')
 DO 9", N 41° W, 12 LKS. (7.92')
 NOTES SHOW DISTANCE NORTH AND SOUTH OF 40.0 CH(2640')

2. CORNER REFERENCED IN PLAT OF BRIARWOOD No. 4, BY FRED N. WHITE, RLS #12034, DATED JAN. 13, 1970 AND RECORDED IN LIBER 29 OF PLATS, PAGE 35, INGHAM COUNTY RECORDS. NO MENTION OF MONUMENT OR WITNESSES GIVEN.
 CONTINUED ON BACK

B. Description of corner evidence found and/or method applied in restoring or reestablishing corner:
 SEARCHED AT APPARENT LOCATION AND FOUND #4 REBAR IN MON. BOX ON CENTERLINE OF KINAWA DRIVE. EXCAVATED INTERIOR OF MON. BOX TO DEPTH OF 3.5 FT., FOUND NO OTHER EVIDENCE. POSITION OF CORNER IS IN ACCORD WITH SURROUNDING SUBDIVISIONS. ACCEPTED LOCATION OF FOUND #4 REBAR AND REPLACED WITH STANDARD INGHAM COUNTY REMON. BAR AND 2 1/2" ALUMINUM CAP.

C. Description of monument for corner and accessories established to perpetuate locating the position of the corner:
 G-11, T4N, R1W, MERIDIAN TOWNSHIP, INGHAM COUNTY. SET STANDARD 3/4" X 24" REMON. BAR WITH 2 1/2" ALUMINUM P.A. 345 CAP STAMPED 30090 IN POSITION OF FOUND #4 REBAR. WITNESSED BY:
 4" CONCRETE MONUMENT, SOUTH, 28.10'
 C/L 2" STEEL PIPE, S 70° W, 34.50'
 C/L MANHOLE, S 34° E, 13.70'
 SET N&T #30090, SW/S 9" ASH, N 44° W, 67.30'
 SET N&T #30090, W/S 16" POPLAR, N 32° E, 60.00'

BEARINGS GIVEN ARE MAGNETIC. STANDARD MONUMENTATION CONSISTS OF A 3/4" X 24" STEEL BAR, WITH A 2 1/2" ALUMINUM CAP STAMPED PA 345, INGHAM COUNTY, #30090.

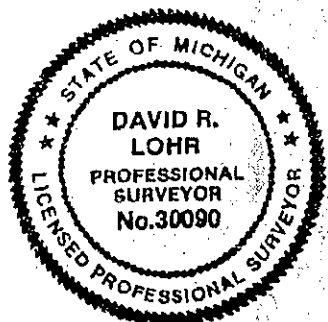

Signed by David R. Lohr

Date 10/1/99

Surveyor's Michigan License No. 30090

P.A. 345 INGHAM COUNTY
 PEER APPROVED 9/21/99 m



G-11: T4N, R1W, MERIDIAN TOWNSHIP, PART A - CONTINUED:

3. CORNER REFERENCED IN LCRC BY RON HELSEL, RLS #18994, DATED MARCH 6, 1974 AND RECORDED IN LIBER 3 OF CORNERS, PAGE 53. PART B STATES: "ORIGINAL CORNER USED IN PLATTING BRIARWOOD SUBDIVISION AT THE INTERSECTION OF N-S AND E-W FENCE ROWS. THIS POST WAS LATER REPLACED BY A STEEL FENCE POST, 8" BELOW SURFACE OF GROUND."
PART C STATES: "STEEL FENCE POST." WITNESSED BY:

N & T NORTH SIDE OF 20" ELM,	SOUTH,	55.51'
N & T NORTH SIDE OF 10" ELM,	S 40° E,	74.80'
N & T EAST SIDE OF 24" ELM,	S 45° W,	83.00'
MONUMENT NE CORNER BRIARWOOD #4,	SOUTH,	330.00'
4. CORNER REFERENCED IN PLAT OF HIDDEN VALLEY, BY MARVIN F. FOUT, RLS #18989, DATED 12/20/76, AND RECORDED IN LIBER 34 OF PLATS, PAGE 9, INGHAM COUNTY RECORDS. NO MENTION OF MONUMENT OR WITNESSES GIVEN. PLAT SHOWS DISTANCE SOUTH TO G-12 OF 2656.88 FT.
5. CORNER REFERENCED IN PLAT OF KINAWA VIEW, BY MARVIN F. FOUTY, RLS #18989, DATED 6/20/77, AND RECORDED IN LIBER 34 OF PLATS, PAGE 30, INGHAM COUNTY RECORDS. NO MENTION OF MONUMENT OR WITNESSES GIVEN. PLAT SHOWS DISTANCE EAST TO I-11 OF 5308.44 FT. (I-11 NOT REFERENCED)
6. CORNER REFERENCED IN PLAT OF BRIARWOOD NO. 6, BY JAMES E. STEPHENS, RLS #16053, DATED 11/13/79, AND RECORDED IN LIBER 36 OF PLATS, PAGE 33, INGHAM COUNTY RECORDS. NO MENTION OF MONUMENT OR WITNESSES GIVEN. PLAT SHOWS CORNER TO BE 28 FEET NORTH OF CORNER OF NORTHWEST CORNER OF PLAT.
7. CORNER REFERENCED IN PLAT OF HIDDEN VALLEY NO. 4, BY MAURICE H. MAHIEU, RLS #28414, DATED 10/15/85, AND RECORDED IN LIBER 40 OF PLATS, PAGE 10, INGHAM COUNTY RECORDS. NO MENTION OF MONUMENT OR WITNESSES GIVEN. PLAT SHOWS DISTANCE SOUTH TO G-12 OF 2656.88 FT.
8. CORNER REFERENCED IN LCRC BY MAURICE H. MAHIEU, RLS #28414, DATED DECEMBER 6, 1985 AND RECORDED IN LIBER 6 OF CORNERS, PAGE 280. PART B STATES: "FOUND 1/2" BAR IN MONUMENT BOX IN KINAWA DRIVE. 1/2" BAR FITS CONTROL FROM SURROUNDING SUBDIVISIONS."
PART C STATES: "1/2" BAR IN MONUMENT BOX LEFT IN PLACE AS CORNER AND WITNESSED BY:"

NAIL AND TAG IN 12" POPLAR,	N 25° E,	68.84 FEET
NAIL AND TAG IN 6" TRIPLE OAK,	N 40° W,	68.37 FEET
4" CONC. MONUMENT,	SOUTH,	28.00 FEET
4" CONC. MONUMENT,	S 50° E,	62.62 FEET
9. NO OTHER REFERENCES FOUND.

SURVEY &
REMONUMENTATION

SECTION