

LAND CORNER RECORDATION CERTIFICATE
 Filing Requirement of Act 74, Mich. P.A. 1970

SECTION

For corners in
INGHAM
 (County)

Located in

Corner Code # 1

Paula Johnson
 INGHAM COUNTY
 REGISTER OF DEEDS
 SUNDBERG CARLSON & ASSOCIAT

L-9 P-517

1999-053021

MERIDIAN TWP.

1 Public Land Survey

T 4N R 1W

G-13



1999-053021
 Page: 1 of 2
 10/21/1999 09:58A

2 Property Controlling in Section	S	T	R	
3 Miscellaneous Property in Sec.	S	T	R	
	S	T	R	

Register of Deeds Stamp & File Number

4 Lot No. _____ Recorded Plat _____
 5 Private Claims _____

I, DAVID R. LOHR, in a field survey on SEPTEMBER 2, 1999, do hereby certify that under requirements of P.A. 74, Michigan P.A. of 1970, the corner points mentioned in lines 1 and 2 above were in conformance with regulations and rules therefore as required in the current manual of survey instructions of the United States Department of the Interior, Bureau of Land Management or by a decree of a Court of Law and/or that the corner points mentioned in lines 3, 4 and 5 above were in conformance with the rules of the Michigan Board of Land Surveyors or by a Decree of a Court of Law; established, re-established, monumented, re-monumented, recovered, found as expressed below:

	A	B	C	D	E	F	G	H	I	J	K	L	M
1													
2	6	5	4	3	2	1							
3													
4	7	8	9	10	11	12							
5													
6	18	17	16	15	14	13							
7													
8	19	20	21	22	23	24							
9													
10	30	29	28	27	26	25							
11													
12	31	32	33	34	35	36							
13													

NOTE: Not more than 2 corners, all in the same town and range, may be recorded on this certificate.

A. Description of original monument and accessories and/or subsequent restoration:
 1. CORNER SET BY LUCIUS LYON, U.S. DEPUTY SURVEYOR IN JANUARY OF 1827.
 "WEST ON S. BOUNDARY OF SEC. 34." AT DISTANCE OF 40.0 0 CH (2640.0').
 "SET POST COR. SECS. 33 & 34. fw" WITNESSED BY:
 BE 7", N 9° E, 35 LKS. (23.10')
 WILLOW 2", N 6° E, 31 3/4 LKS. (20.96')
 DO, 22", N 87° W, 32 LKS. (21.12')

NOTES SHOW DISTANCE EAST AND WEST OF 40.0 CH (2640')
 NOTE: GLO FALLING OF G-1 ALAIEDON TWP. (T3N, R1W) IS 110 LKS (72.60 FT.) WEST OF THIS CORNER

2. CORNER REFERENCED IN SURVEY BY A. JACKSON, COUNTY SURVEYOR, DATED MAY 16, 1848 AND RECORDED IN BOOK 4, PAGE 228, COUNTY SURVEYOR RECORDS. NO MENTION OF MONUMENT. WITNESSED BY:
 BEECH 22", N 67 1/4° W, 32 LKS. (21.12')
 DO 9", N 09° E, 35 LKS. (23.10')
 SURVEY SHOWS DISTANCE EAST OF 39.75 CH (2623.50') AND NORTH OF 40.11 CH (2647.26')

CONTINUED ON BACK


B. Description of corner evidence found and/or method applied in restoring or reestablishing corner:

SEARCHED AT APPARENT LOCATION AND FOUND #6 REBAR IN MON. BOX ON CENTERLINE OF JOLLY ROAD. JOLLY ROAD HAS RECENTLY BEEN REBUILT WITH THIS CORNER FALLING IN A 3 FT. TO 4 FT. CUT AREA. NO EXCAVATION PERFORMED. ACCEPTED FOUND #6 REBAR AS CORNER AND SET 2 1/2" ALUMINUM P.A. 345 CAP STAMPED 30090 ON IT. POSITION MATCHES GLO DISTANCE OF 72.60 FT. WEST TO G-1 ALAIEDON TOWNSHIP.

C. Description of monument for corner and accessories established to perpetuate locating the position of the corner:

G-13, T4N, R1W, MERIDIAN TOWNSHIP, INGHAM COUNTY. FOUND #6 REBAR IN MON. BOX, CAPPED IT WITH 2 1/2" ALUMINUM P.A. 345 CAP STAMPED 30090. WITNESSED BY:
 SOUTHWEST CORNER BRICK HOUSE, N 23° E, 103.80'
 SET N&T #30090, NE/S P. POLE, N 54° W, 49.90'
 SET N&T #30090, W/S 19" MAPLE, N 26° E, 69.50'
 SET N&T #30090, W/S 15" MAPLE, N 62° E, 106.00'
 G-1 ALAIEDON (#6 STEEL BAR) N 86° W, 72.60'

BEARINGS GIVEN ARE MAGNETIC.

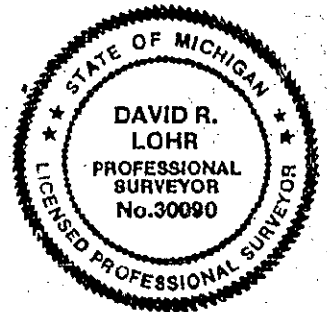

Signed by David R. Lohr

Date 10/1/99

Surveyor's Michigan License No. 30090

P.A. 345 INGHAM COUNTY
 PEER APPROVED 9/21/99 RL



G-13: T4N, R1W, MERIDIAN TOWNSHIP, PART A - CONTINUED:

3. CORNER REFERENCED IN SURVEY BY T.J. BROWN, COUNTY SURVEYOR, DATED JAN. 3, 1874 AND RECORDED IN BOOK 2, PAGE 103, COUNTY SURVEYOR RECORDS. "A POST". WITNESSED BY:
WILLOW 2", N 5° E, 42 1/4 LKS. (27.89')
SURVEY SHOWS DISTANCES WEST AND NORTH OF 40.00 CH (2640')
4. CORNER REFERENCED IN INGHAM COUNTY ROAD COMMISSION GRID MAP DATED 1-1-72 AS "MON. BOX."
WITNESSED BY: 15" CHERRY, SE, 65.57'
UTILITY POLE, WNW, 47.34'
30"STP. (STUMP) SW, 96.49
5. CORNER REFERENCED IN LCRC BY MARVIN F. FOUTY, RLS #18989, DATED JULY 15, 1974 AND RECORDED IN LIBER 3 OF CORNERS, PAGE 253. PART B STATES: "G-13, RECORDS OF EIGHT LOCAL REGISTERED SURVEYOR DISCLOSED NO EVIDENCE OF CORNER LOCATION. SET 1/2" BAR IN MONUMENT BOX ON TOWNSHIP LINE AT OLD FENCE LINE NORTH. PROPORTIONAL MEASUREMENT EAST AND WEST IN CLOSE ACCORD WITH ORIGINAL GOVERNMENT MEASURE. CORNER 9' NORTH OF CENTERLINE OF JOLLY ROAD.
PART C STATES: "SE CORNER SECTION 33, T4N, R1W 1/2" BAR IN MONUMENT BOX." WITNESSED BY:
NAIL AND TAG NE SIDE 15" WILD CHERRY, SE, 65.57'
NAIL AND TAG SE SIDE UTILITY POLE, WNW, 47.34'
NAIL AND TAG NORTH SIDE 30"STUMP, SW, 96.49
6. CORNER REFERENCED IN SURVEY BY JAMES A. PORTER, RLS #19003, DATED 5/24/76 AND RECORDED IN LIBER 2 OF SURVEYS, PAGE 314. NO MENTION OF MONUMENT OR WITNESSES. NOTED AS "PREV. RECORDED."
DRAWING SHOWS FALLING OF 72.60 FT. WEST TO G-1 ALAIEDON TWP. AND DISTANCE EAST TO H-1 OF 2576.86 FT.
7. CORNER REFERENCED IN SURVEY PLAN OF EAST MEADOWS CONDOMINIUM, INGHAM COUNTY CONDOMINIUM NO. 20, BY MARVIN F. FOUTY, RLS #18989, DATED SEPT. 26, 1977 AND RECORDED IN LIBER 1236, PAGE 703. "G-13, SE COR. SECTION 33, T4N, R1W." NO MENTION OF MONUMENT OR WITNESSES GIVEN. SHOWS DISTANCE NORTH TO G-12 OF 2631.68 FT.
8. CORNER REFERENCED IN SURVEY BY MAURICE H. MAHIEU, RLS #28414, DATED 11/19/84 AND RECORDED IN LIBER 4 OF SURVEYS, PAGE 952. "SOUTHWEST CORNER, SEC. 34, T4N, R1W, MERIDIAN TWP. FOUND 1/2 BAR."
WITNESSED BY: 15" CHERRY, SE, 65.57'
UTILITY POLE, WNW, 47.34'
30"STP. (STUMP) SW, 96.49
SHOWS DISTANCE EAST TO H-13 OF 2641.17 FT.
9. CORNER REFERENCED IN SURVEY, BY MARVIN F. FOUTY, RLS #18989, DATED 3/1/89 AND RECORDED IN LIBER 6, PAGE 811. "G-13, SE CORNER, SECTION 33, T4N, R1W. (REC. L.3,P.253) FOUND IRON IN MON."
SHOWS DISTANCE EAST TO H-13 OF 2641.15 FT.
10. CORNER REFERENCED IN SURVEY BY LARRY A. BRYAN, LLS #25832, DATED 9/8/89 AND RECORDED IN LIBER 6 OF SURVEYS, PAGE 110. "SOUTHEAST CORNER, SECTION 34, T4N, R1W, LIBER 3, PAGE 253. FOUND 1/2" BAR IN MONUMENT BOX 9' NORTH OF CENTERLINE OF JOLLY ROAD." WITNESSED BY:
FOUND NAIL & TAG #18989 (MARV FOUTY) NORTHEAST SIDE POWER POLE, N 70° W, 47.35'
FOUND NAIL & TAG #25832 NORTH SIDE 18" WILD CHERRY, S 50° E, 65.57'
SOUTHWEST CORNER BRICK HOUSE, N 15° E, 102.70'
SHOWS DISTANCE WEST TO F-13 OF 2641.52 FT.
11. CORNER REFERENCED IN SURVEY BY LARRY A. BRYAN, LLS #25832, DATED 11/9/89 AND RECORDED IN LIBER 6 OF SURVEYS, PAGE 84. "SOUTHEAST CORNER, SECTION 34, T4N, R1W, NO MENTION OF MONUMENT OR WITNESSES GIVEN. SHOWS DISTANCE WEST TO F-13 OF 2641.52 FT.
12. CORNER REFERENCED IN SURVEY BY MARVIN F. FOUTY, RLS #18989, DATED 9-15-92 AND RECORDED IN LIBER 6 OF SURVEYS, PAGE 1047. "SE CORNER, SECTION 33, T4N, R1W. (PREV. REC). SURVEY SHOWS DISTANCE WEST OF 2641.60'.
13. CORNER REFERENCED IN PLAT OF SPRING LAKE NO. 7, BY JAMES E. STEPHENS, LLS #16053, DATED 10/03/90, AND RECORDED IN LIBER 46 OF PLATS, PAGE 27, INGHAM COUNTY RECORDS. NO MENTION OF MONUMENT OR WITNESSES GIVEN. (REFERS TO LIBER 3, PAGE 253. PLAT SHOWS DISTANCE NORTH TO G-12 OF 2631.76 FT.
14. CORNER REFERENCED IN PLAT OF HIAWATHA LAKE NO. 5, BY JAMES E. STEPHENS, LLS #16053, DATED 9/29/95, AND RECORDED IN LIBER 50 OF PLATS, PAGE 11, INGHAM COUNTY RECORDS. NO MENTION OF MONUMENT OR WITNESSES GIVEN. (REFERS TO LIBER 3, PAGE 253. PLAT SHOWS DISTANCE NORTH TO G-12 OF 2631.80 FT.
15. CORNER REFERENCED IN PLAT OF SPRING LAKE NO. 9, BY JAMES E. STEPHENS, LLS #16053, DATED 7/31/96, AND RECORDED IN LIBER 51 OF PLATS, PAGE 16, INGHAM COUNTY RECORDS. NO MENTION OF MONUMENT OR WITNESSES GIVEN. (REFERS TO LIBER 3, PAGE 253. PLAT SHOWS DISTANCE EAST TO H-13 OF 2641.44 FT.
16. CORNER REFERENCED IN PLAT OF HIAWATHA LAKE NO. 7, BY JAMES E. STEPHENS, LLS #16053, DATED 6/18/98, AND RECORDED IN LIBER 52 OF PLATS, PAGE 18, INGHAM COUNTY RECORDS. NO MENTION OF MONUMENT OR WITNESSES GIVEN. (REFERS TO LIBER 3, PAGE 253) PLAT SHOWS DISTANCE NORTH TO G-12 OF 2631.80 FT. AND WEST TO F-13 OF 2625.12 FT.
17. NO OTHER REFERENCES FOUND.

Ingham Co