

NOV 30 1993

COMMISSION

LAND CORNER RECORDATION CERTIFICATE
Filing Requirement of Act 74, Mich. P.A. 1970

OCT 27 10 57 AM '93

For corners in

<u>Ingham</u> (County)	Located In:	Corner Code #
1. Public Land Survey	T <u>4N</u> R <u>1W</u>	<u>J-11</u>
	T _____ R _____	_____
	T _____ R _____	_____
	T _____ R _____	_____
2. Property Controlling in Section	S _____ T _____ R _____	_____
	S _____ T _____ R _____	_____
3. Miscellaneous Property in Sec.	S _____ T _____ R _____	_____
	S _____ T _____ R _____	_____

REGISTER OF DEEDS
D. J. Johnson
INGHAM COUNTY, MICH.

Register of Deeds Stamp & File Number

- 4. Lot No. _____, Recorded Plat _____
- 5. Private Claims _____

A	B	C	D	E	F	G	H	I	J	K	L	M
2	6	5	4	3	2	1						
3												
4	7	8	9	10	11	12						
5												
6	18	17	16	15	14	13						
7												
8	19	20	21	22	23	24						
9												
10	30	29	28	27	26	25						
11												
12	31	32	33	34	35	36						
13												

I, Larry A. Bryan, in a field survey on September 14th, 19 93, do hereby certify that under requirements of P.A. 74, Michigan P.A. of 1970, the corner points mentioned in lines 1 and 2 above were in conformance with regulations and rules therefore as required in the current manual of survey instructions of the United States Department of the Interior, Bureau of Land Management or by a decree of a Court of Law and/or that the corner points mentioned in lines 3, 4 and 5 above were in conformance with the rules of the Michigan Board of Land Surveyors or by a Decree of a Court of Law; established, re-established, monumented, re-monumented, recovered, found as expressed below:

NOTE: Not more than 4 corners, all in the same town and range, may be recorded on this certificate.

A. Description of original monument and accessories and/or subsequent restoration:
J-11,

- 1. Set 1/4 Sec. post on true line (From GLO Notes of Lucius Lyon, Deputy Surveyor, 1827)
W.O. 3in. N31E 52lks
B.O. 8" S43E 26"


(Continued on Back)

B. Description of corner evidence found and/or method applied in restoring or reestablishing corner:

J-11, Investigation at this corner location revealed a 1 1/2" pipe on wire fence remains to West and South. Proved pipe to be the perpetuated location of J-11 by the Stephens' witnesses in #3 above.

C. Description of monument for corner and accessories established to perpetuate locating the position of the corner:

- J-11, T4N-R1W
1 1/2" pipe as noted above
Found nail and tag #16053 West side 20" Oak, N48°E, 33.15'
Set nail and tag #25832 South side 20" Cherry, N86°W, 15.09'
Set nail and tag #25832 West side 16" Ash, 37.04'
Set nail and tag #25832 West side West trunk twin 8" Oak, N12°W, 37.15'

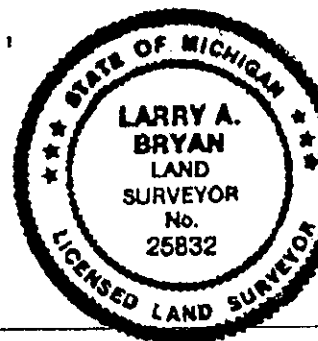

Signed by Larry A. Bryan

Date 10-13-93

Surveyor's Michigan License No. 25832

PART "A" CONTINUED

2. In a survey dated April 13, 1879 (Vol. 2, P. 84), Louis D. Preston, County Surveyor, recorded the original Quarter Post gone but gave the following witnesses with no particular monument noted:

White Oak 15 S29W 39L
W Oak 16 N22W 66L

3. James E. Stephens, LS #16053, recorded corner on 01/18/77 in Liber 4 of Corners, Page 3, as having found a 1 1/2" iron pipe at the base of an old fence, with pieces of the fence found North, South, and West of the corner, stating he had checked the records of 6 area Registered Land Surveyors, with the following witnesses:

Survey tag on the East side of a 16" Wild Cherry, N86°01'W, 14.66 feet
Survey tag on the Southwest side of a 12" Oak, N48°27'E, 33.21 feet
Survey tag on the Northwest side of a 8" Maple, S24°44'E, 36.81 feet

4. John A. Sellek, LS #2265, recorded corner on 05/15/80 in Liber 4 of Surveys, Pages 26-27, as having found a 1 1/2" pipe with the same witnesses as #3 above.

