

NOV 30 1993

COMMISSION

LAND CORNER RECORDATION CERTIFICATE  
Filing Requirement of Act 74, Mich. P.A. 1970

OCT 27 10 56 AM '93

For corners in

Ingham  
(County)

Located In:

Corner Code #

- 1. Public Land Survey      T 4N R 1W      K-9
- T \_\_\_\_\_ R \_\_\_\_\_
- T \_\_\_\_\_ R \_\_\_\_\_
- T \_\_\_\_\_ R \_\_\_\_\_
- 2. Property Controlling    S \_\_\_\_\_ T \_\_\_\_\_ R \_\_\_\_\_
- in Section               S \_\_\_\_\_ T \_\_\_\_\_ R \_\_\_\_\_
- 3. Miscellaneous           S \_\_\_\_\_ T \_\_\_\_\_ R \_\_\_\_\_
- Property in Sec.         S \_\_\_\_\_ T \_\_\_\_\_ R \_\_\_\_\_

REGISTER OF DEEDS  
*Paul J. Johnson*  
INGHAM COUNTY, MICH.

Register of Deeds Stamp & File Number

- 4. Lot No. \_\_\_\_\_, Recorded Plat \_\_\_\_\_
- 5. Private Claims \_\_\_\_\_

	A	B	C	D	E	F	G	H	I	J	K	L	M
2	6		5		4		3		2		1		
3													
4	7		8		9		10		11		12		
5													
6	16		17		18		19		20		21		22
7													
8	19		20		21		22		23		24		
9													
10	30		29		28		27		26		25		
11													
12	31		32		33		34		35		36		
13													

I, Larry A. Bryan, in a field survey on September 14, 19 93, do hereby certify that under requirements of P.A. 74, Michigan P.A. of 1970, the corner points mentioned in lines 1 and 2 above were in conformance with regulations and rules therefore as required in the current manual of survey instructions of the United States Department of the Interior, Bureau of Land Management or by a decree of a Court of Law and/or that the corner points mentioned in lines 3, 4 and 5 above were in conformance with the rules of the Michigan Board of Land Surveyors or by a Decree of a Court of Law; established, re-established, monumented, re-monumented, recovered, found as expressed below:

NOTE: Not more than 4 corners, all in the same town and range, may be recorded on this certificate.

A. Description of original monument and accessories and/or subsequent restoration:  
K-9,

- 1. Set post cor. to Secs. 23, 24, 25 & 26 (From GLO Notes of Lucius Lyon, Deputy Surveyor, 1827)
- W.O. 10in. N34E 40lks.
- Do. 9" N46W 26"


(Continued on Back)

B. Description of corner evidence found and/or method applied in restoring or reestablishing corner:

K-9, Investigation at this corner location revealed a 1 1/2" square bar on a fence to the North. The witnesses of MSHD and the subsequent surveyors listed matched closely with the location of the 1 1/2" bar, and therefore it was accepted as the perpetuated location of K-9.

C. Description of monument for corner and accessories established to perpetuate locating the position of the corner:

- K-9, T4N-R1W
- Found 1 1/2" square bar as noted above
- Found nail and tag #25832 North side 12" Cherry, East, 41.02'
- Northwest corner garage foundation, house #955, N65°E, 159.20'
- Set nail and tag #25832 South side 8" Cherry, S65°E, 37.33'
- Northeast leg of Consumers Power Transmission Tower at base, S15°W, 47.49'

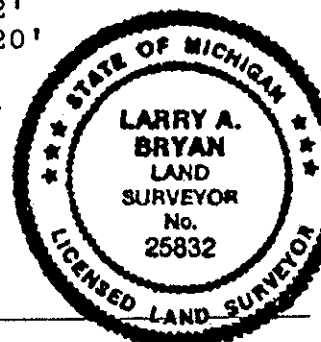

Signed by Larry A. Bryan  
Surveyor's Michigan License No. 25832

Date 10-13-93

## PART "A" CONTINUED

2. The Michigan State Highway Department (MSHD) on 05/25/59, with C. Smith as the Survey Chief, found a 1 1/8" iron with the following witness:  
Consumers Power Co. Tower #2930 N.E. Corner S15W 47.6'
3. The MSHD in April 1967, with C.E. Smith as the Survey Chief, found a 1 1/2" iron with the following witnesses:  
4" Hickory Due N 19.80  
6" W. Cherry Due E 41.13  
Base NW Leg Tower #9820 S24W 51.60
4. James E. Stephens, LS #16053, recorded corner on 08/13/71 in Liber 1 of Corners, Page 111, and on 08/16/71 in Liber 1 of Surveys, Page 56, as having found a 1 1/2" square iron bar at the intersection of three old farm fences with the following witnesses:  
S28°49'W 3.20 feet to a Stephens Engineering tag in a 6 inch Oak  
S7°47'W 48.0 feet to the NE. corner of a Consumers Power Company transmission tower  
Stephens tag in a 6 inch Oak S6°17'E 20.80 feet
5. Ron Helsel, LS #18994, recorded corner on 03/27/74 in Liber 1 of Surveys, Page 1177, as having found a 1 1/2" iron with the following witnesses:  
S7°47'W, 48.0 ft., tag 6" Oak  
S6°17'E, 20.80 ft., tag 6" Oak  
S7°47'W, 48.0 ft., NE Cor. Cons. Power Trans Tower
6. James E. Stephens, LS #16053, recorded corner on 12/04/78 in Liber 3 of Surveys, Pages 641-648, and on 09/16/82 in Liber 4 of Surveys, Page 574, as having found a 1 1/2" square iron bar with the same witnesses as listed in #4 above.
7. Marvin F. Fouty, LS #18989, recorded corner on 01/18/81 in Liber 4 of Surveys, Pages 305 & 311, as having found a 1 1/2" square iron bar with the following witnesses:  
Tag in 6" Oak SW 3.20'  
NE Cor. Consumers Power Co. Transmission Tower SW 48.0'  
Tag in 6" Oak SE 20.80'
8. Austin C. Williams, LS #21275, recorded corner on 03/22/83 in Liber 4 of Surveys, Pages 654-655, with no monument mentioned, with the same witnesses as listed in #4 above.
9. Larry A. Bryan, LS #25832, witnessed corner on 12/20/90 in a survey with Job #90-B-31109, as having found a 1 1/2" square bar on fence lines North and West with the following witnesses:  
Set nail and tag #25832 South side 14" Cherry, East, 41.23'  
Centerline Southwest bolt of satellite dish, N30°E, 113.58'  
Northeast corner of Northeast leg C.P.C. Tower, S08°W, 48.00'
10. David R. Lohr, LS #30090, recorded corner on 02/08/93 in Liber 6 of Surveys, Pages 1110-1111, showing a distance of 2642.41' to L-9, with no particular monument noted and no witnesses given for K-9.