

DEC 14 1993

FILED

COMMISSION

Nov 15 11 40 AM '93

LAND CORNER RECORDATION CERTIFICATE
Filing Requirement of Act 74, Mich. P.A. 1970

REGISTER OF DEEDS
Dennis J. Johnson
INGHAM COUNTY, MICH.

For corners in

Table with columns: Ingham (County), Located In:, Corner Code #. Row 1: Public Land Survey, T 4N R 1W, K-10.

Register of Deeds Stamp & File Number

4. Lot No. , Recorded Plat
5. Private Claims

Grid table with columns A-M and rows 2-13. Cell (10, J) contains a black dot.

I, Larry A. Bryan, in a field survey on October 5, 1993, do hereby certify that under requirements of P.A. 74, Michigan P.A. of 1970, the corner points mentioned in lines 1 and 2 above were in conformance with regulations and rules therefore as required in the current manual of survey instructions of the United States Department of the Interior, Bureau of Land Management or by a decree of a Court of Law and/or that the corner points mentioned in lines 3, 4 and 5 above were in conformance with the rules of the Michigan Board of Land Surveyors or by a Decree of a Court of Law; established, re-established, monumented, re-monumented, recovered, found as expressed below:

NOTE: Not more than 4 corners, all in the same town and range, may be recorded on this certificate.

A. Description of original monument and accessories and/or subsequent restoration: K-10,

- 1. In 1827, Lucius Lyon, U.S. Deputy Surveyor, Set 1/4 Sec Post
Maple 4in. N88W 42lks
B. Ash 8 " S76E 18"

(Continued on Back)

B. Description of corner evidence found and/or method applied in restoring or reestablishing corner:


K-10, Investigation at this corner location revealed a 1" pipe in a 8" clay tile +/-40' South of North edge of swamp under East line of Consumers Power Company wires. The 6" Maple in Item #3 above was found as well as Stephens tags in the two trees listed in Item #5. The 1" pipe was therefore accepted as the perpetuated location of K-10.

C. Description of monument for corner and accessories established to perpetuate locating the position of the corner:

K-10, T4N-R1W
Found 1" pipe in 8" clay tile as noted above.
Found nail & tag #16053 Northwest side 10" Hickory, N60°E, 76.21'
Base of Southeast leg Consumers Power Tower, N03°W, 97.80'
Set nail & tag #25832 North side 12" Maple, N75°E, 55.84'
Set nail & tag #25832 South side 8" Oak, N40°W, 96.88'

Signed by [Signature]
Surveyor's Michigan License No. 25832

Date 10-5-93

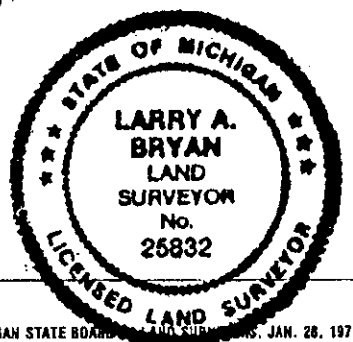

## PART "A" CONTINUED

2. Louis D. Preston, County Surveyor, recorded corner on April 13th, 1879 (Vol.2 P.84 of County Surveyor Records), as an original 1/4 Post with no witnesses given.
3. Phil Wetoskey, LS #19847, of the Michigan State Highway Department, witnessed corner in April 1967 as having found a 1" gas pipe witnessed by:  
 N50W 39.34 4" Oak  
 N22E 39.63 4" Maple  
 N75E 56.02 6" Maple  
 (from MDSH witness records)
4. Charles C. Wilson, LS #13604, recorded corner on 08/31/72 in Liber 2 of Corners, Page 89, as having found a 1 1/2" pipe in 8" tile in old fence N-S, 50' S of old fence E'LY, witnessed by:  
 SE corner of tower N'LY 98'  
 at North edge of swamp
5. James E. Stephens, LS #16053, recorded corner on 10/30/78 in Liber 5 of Corners, Page 64, and on 12/04/78 in Liber 3 of Surveys, Pages 641-652, as having found a 1" iron pipe inside a 10" clay pipe witnessed by:  
 N3°W 97.97' to SE edge of base of SE leg of power tower  
 N75°E 55.84' to nail and tag in North side of 11" Maple Tree  
 N60°E 76.21' to nail and tag in NW side of twin 10" Shagbark Hickory Tree
6. Austin C. Williams, LS #21275, recorded corner on 11/17/78 in Liber 3 of Surveys, Pages 612-613, and on 04/02/79 in Liber 3 of Surveys, Pages 821-822, with no particular monument noted witnessed by:  
 SE corner of tower N'ly 98' at edge of swamp
7. Douglas K. Richardson, LS #31603, recorded corner on 11/23/88 in Liber 5 of Surveys, Page 541, with no particular monument noted and no witnesses given.

2556

