

Nov 30 8 11 AM '94

LAND CORNER RECORDATION CERTIFICATE
Filing Requirements of Act 74, Mich. P.A. 1970

REMONUMENTATION COMMISSION
APR 10 1995
For corner of Ingham County Locke

REGISTERED LAND SURVEYOR
THE STATE OF MICHIGAN

Located In: _____ Corner Code #: C-2

1. Public Land Survey	T <u>4N</u>	R <u>2E</u>	_____
	T _____	R _____	_____
	T _____	R _____	_____
	T _____	R _____	_____
2. Property Controlling in Section	S _____	T _____	R _____
	S _____	T _____	R _____
3. Miscellaneous Property in Sec.	S _____	T _____	R _____
	S _____	T _____	R _____

4. Lot No. _____, Recorded Plat _____

5. Private Claims _____

Register of Deeds Stamp & File Number

I, Marvin Fouty, in a field survey on Aug. 23, 19 94, do hereby certify that under requirements of P.A. 74, Michigan P.A. of 1970, the corner points mentioned in lines 1 and 2 above were in conformance with regulations and rules therefore as required in the current manual of survey instructions of the United States Department of the Interior, Bureau of Land Management or by a decree of a Court of Law and/or that the corner points mentioned in lines 3, 4 and 5 above were in conformance with the rules of the Michigan Board of Land Surveyors or by a Decree of a Court of Law, established, re-established, monumented, re-monumented, recovered, found as expressed below:

A	B	C	D	E	F	G	H	I	J	K	L	M
2	6	5	4	3	2	1						
3												
4	7	8	9	10	11	12						
5												
6	18	17	16	15	14	13						
7												
8	19	20	21	22	23	24						
9												
10	30	29	28	27	26	25						
11												
12	31	32	33	34	35	36						
13												

NOTE: Not more than 4 corners, all in the same town and range, may be recorded on this certificate.

A. Description of original monument and accessories and/or subsequent restoration:


1. Post set in original Government Survey by Joseph Wampler in April 1826 with the following witnesses:
Iron^d 9 N43E 31, B.O. 8 N37W 24
2. T.J. Brown, County surveyor, reported using corner in survey dated Sept. 2, 1864 and recorded in Vol. 3, Page 15 of County Surveyors Records with no mention of monument and the following witnesses:
Swamp White Oak (double) 24" (no distance noted) S5-1/2°E and Ironwood 10" N54°E 31 links.
3. The corner monument, a 1/2" bar & cap No. 18998 was set with no witnesses at the intersection of fence lines by Surveyor Ron Lester LS# 18998 in May of 1981. The unrecorded records of the results of the survey were supplied me by Surveyor Lester. The work was done for the Ingham County Remonumentation program.

B. Description of corner evidence found and/or method applied in restoring or reestablishing corner:

Traversed Section and Found 1/2" bar & cap No. 18998 at the extension of old fence lines S, E, and W. The iron was in the middle of a farmer's lane in a water ponded area. Excavated a 4' dia hole 2 feet deep and probed but found nothing. Measurements from the corner iron are: Lester W2610.74'; Fouty W2610.43'; Lester N3750.44'; Fouty N3751.34'; GLO records (3726.36'); County Surveyor Brown's notes E39.36 ch (2597.76'); Fouty E2617.43'; Lester S2643.56'; Fouty S2643.94'; County Surveyor Brown no dimension. Accepted the Lester iron as the best evidence of the perpetuated location of the corner and replaced found bar and cap with Standard 3/4" x 24" Ingham County Remonumentation Bar and PA345 Cap #18989.

C. Description of monument for corner and accessories established to perpetuate locating the position of the corner:

- Standard 3/4" x 24" Ingham County Remonumentation Bar and PA345 Cap #18989.
- Nail & Tag West side 30" Oak S05°W 21.70'
- Nail & Tag South side 10" Oak East 23.28'
- Nail & Tag West side 10" Ash N10°E 48.27'
- Nail & Tag West side 10" Ash N10°W 31.63'
- Nail & Tag North side 12" Ash N80°W 57.07'

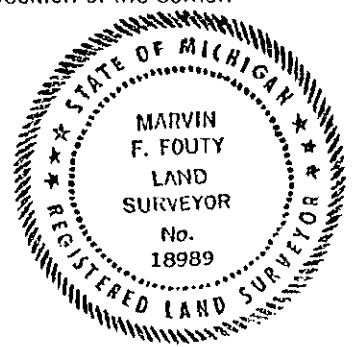

Signed by Marvin Fouty Date Aug. 30, 1994
Surveyor's Michigan License No. 18989