

Nov 30 8 13 AM '94

APR 10 1995

LAND CORNER RECORDATION CERTIFICATE
Filing Requirement of Act 74, Mich. P.A. 1970

For corners in

Ingham
(County)
Locke

Located In:

Corner Code #

1. Public Land Survey	T <u>4N</u> R <u>2E</u>	<u>C-3</u>
	T _____ R _____	_____
	T _____ R _____	_____
	T _____ R _____	_____
2. Property Controlling in Section	S _____ T _____ R _____	_____
	S _____ T _____ R _____	_____
3. Miscellaneous Property in Sec.	S _____ T _____ R _____	_____
	S _____ T _____ R _____	_____

REGISTER OF DEEDS
TREASURY DEPARTMENT
INGHAM COUNTY, MICH.

Register of Deeds Stamp & File Number

- 4. Lot No. _____, Recorded Plat _____
- 5. Private Claims _____

A	B	C	D	E	F	G	H	I	J	K	L	M
2	6	5	4	3	2	1						
3		●										
4	7	8	9	10	11	12						
5												
6	16	17	16	15	14	13						
7												
8	19	20	21	22	23	24						
9												
10	30	29	28	27	26	25						
11												
12	31	32	33	34	35	36						
13												

I, Marvin Fouty, in a field survey on Aug. 23, 19 94, do hereby certify that under requirements of P.A. 74, Michigan P.A. of 1970, the corner points mentioned in lines 1 and 2 above were in conformance with regulations and rules therelore as required in the current manual of survey instructions of the United States Department of the Interior, Bureau of Land Management or by a decree of a Court of Law and/or that the corner points mentioned in lines 3, 4 and 5 above were in conformance with the rules of the Michigan Board of Land Surveyors or by a Decree of a Court of Law; established, re-established, monumented, re-monumented, recovered, found as expressed below:

NOTE: Not more than 4 corners, all in the same town and range, may be recorded on this certificate.

A. Description of original monument and accessories and/or subsequent restoration:


- 1. Post set in original Government Survey by Joseph Wampler in April 1826, witnessed by:
Tam 9 S 51/2E 84-1/2 W.O. 9 S62E 200
- 2. Larry A. Bryan LS# 25832 recorded corner on August 27, 1979 in Liber 5 of Corners, Page 283 Ingham Co. Records as a Found decayed anchor post surrounded by numerous 4"-8" diameter stones at the intersection of fence lines E, W, & S. The corner was replaced by 1/2" iron bar with cap in center of decayed anchor post with the following witnesses: Nail and tag in West side of 8" Ash, S30°E, 3.48' Nail and tag in West side of 22" Maple, N30°E, 30.54'; Nail and tag in West side of 20" Maple, N50°E 32.69' (Continued on back)

B. Description of corner evidence found and/or method applied in restoring or reestablishing corner:

Traversed Section and Found 1/2" bar & cap No. 25832 in decayed anchor post and fence lines E, W & S, with one of the Bryan witnesses remaining, the 8" Ash which has been cut off at the top; Excavated around post and found traces of stones. Measurements from the corner are: Bryan W2624.22'; Lester W2625.61'; Fouty W2624.89'; Lester N2643.56'; Fouty N2643.94'; Bryan E 2612.32'; Fouty E2611.64'; Bryan S2643.95'; Fouty S2643.27'. Accepted the Bryan iron as the best evidence of the perpetuation of the corner and replaced found bar and cap with Standard 3/4" x 24" Ingham County Remonumentation Bar and PA345 Cap #18989.

C. Description of monument for corner and accessories established to perpetuate locating the position of the corner:

- Standard 3/4" x 24" Ingham County Remonumentation Bar and PA345 Cap #18989.
- Set Nail & Tag SW Side 18" Maple S 40°W 17.08'
- Set Nail & Tag S Side 10" Maple West 50.88'
- Set Nail & Tag E Side 24" Maple N15°W 72.08'
- Set Nail & Tag NE Side 18" Ash S70°E 47.58'
- Set Nail & Tag E Side twin 18" Maple S05°E 43.95'
- Found Nail & Tag #25832 in 8" Ash stump S30°E, 3.3'.

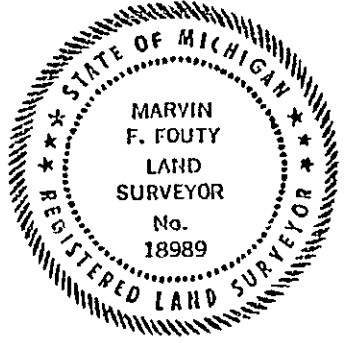

Signed by Marvin Fouty Date Aug. 30, 1994

Surveyor's Michigan License No. 18989

Harry A. Bryan LS# 25832 used corner in a survey on June 20, 1979 recorded in Liber 3 of Surveys, Page 931
at 1/2" bar and cap at fence intersection with same witnesses as in item # 2.

Surveyor Bryan's corner was tied into the survey of the Section as a 1/2" b & c, Bryan with no witness reference by
Surveyor Ron Lester LS# 18998 in May of 1981. The unrecorded records of the results of the survey were supplied me by
Surveyor Lester. The work was done for the Ingham County Remonumentation program.