

SURVEY & REMONUMENTATION COMMISSION

For corners in APR 10 1995

LIBER 8 PAGE 366

FILED

Nov 30 8 13 AM '94

LAND CORNER RECORDATION CERTIFICATE
Filing Requirement of Act 74, Mich. P.A. 1970

REGISTER OF DEEDS
INGHAM COUNTY, MICH.

	Located In:	Corner Code #
1. Public Land Survey	T <u>4N</u> R <u>2E</u>	<u>C-5</u>
	T _____ R _____	_____
	T _____ R _____	_____
	T _____ R _____	_____
2. Property Controlling in Section	S _____ T _____ R _____	_____
	S _____ T _____ R _____	_____
3. Miscellaneous Property in Sec.	S _____ T _____ R _____	_____
	S _____ T _____ R _____	_____

Register of Deeds Stamp & File Number

4. Lot No. _____, Recorded Plat _____
5. Private Claims _____

I, Marvin Fouty, in a field survey on Aug. 23, 19 94, do hereby certify that under requirements of P.A. 74, Michigan P.A. of 1970, the corner points mentioned in lines 1 and 2 above were in conformance with regulations and rules therefore as required in the current manual of survey instructions of the United States Department of the Interior, Bureau of Land Management or by a decree of a Court of Law and/or that the corner points mentioned in lines 3, 4 and 5 above were in conformance with the rules of the Michigan Board of Land Surveyors or by a Decree of a Court of Law; established, re-established, monumented, re-monumented, recovered, found as expressed below:

	A	B	C	D	E	F	G	H	I	J	K	L	M
2	6		5		4		3		2		1		
3													
4	7		8		9		10		11		12		
5													
6	18		17		16		15		14		13		
7													
8	19		20		21		22		23		24		
9													
10	30		29		28		27		26		25		
11													
12	31		32		33		34		35		36		
13													

NOTE: Not more than 4 corners, all in the same town and range, may be recorded on this certificate.

A. Description of original monument and accessories and/or subsequent restoration:


1. Post set in original Government Survey by Joseph Wampler in April 1826 with the following witnesses:
Elm 12 S11E 12 DO 13 N70E 13
2. Surveyor Clyde K. Stephens LS# 3829 recorded the corner on July 26, 1972 in Liber 2 of Corners, Page 13 Ingham Co. Records as a found 1/2" iron rod in the centerline of 2 section line Roads (Haslett & Harris) and on a projection of an old fence north of the corner with the following witnesses: Survey tag in the South side of a utility pole N40°58'W 42.53'; Survey tag in the South side of a utility pole N36°25'E 34.65'; Survey tag in the North side of a utility pole S23°03'E 74.75'

B. Description of corner evidence found and/or method applied in restoring or reestablishing corner:

Found a 1/2" bar in the center of Haslett Road on the centerline of Harris Road to the South and a fence line to the north from witnesses. The C. Stephens witness in power pole in item 2A was intact, the other 2 Stephens power poles were gone. One witness from the ICRC records was intact, the twin 6", 8" Ash SE 73.43. The Measurements from the corner are Bryan E2612.33; Fouty E2612.51'; Bryan N2638.63'; Fouty N2638.90'; There was no record of the County Surveyor perpetuating the corner. I accepted the corner position as the best evidence of the corner and replaced the 1/2" bar with Standard 3/4" x 24" Ingham County Remonumentation Bar and PA345 Cap #18989 in monument box.

C. Description of monument for corner and accessories established to perpetuate locating the position of the corner:

- Standard 3/4" x 24" Ingham County Remonumentation Bar and PA 345 Cap #18989 in monument box.
- Set Nail & Tag #16053 (J. Stephens) S face of Power Pole N 40°W 42.53'
- Set Nail & Tag #18989 W Side twin 18" Ash S. 43°E 73.50'
- Set Nail & Tag #18989 SE side 20" Hickory S75°W 100.72'
- Found Nail & Tag #18989 W face 36" Ash N08°W 56.80'

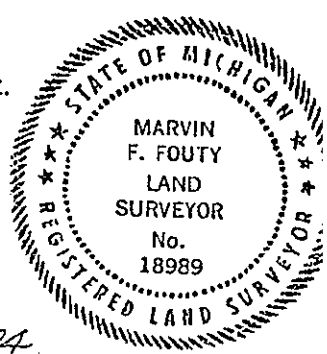

Signed by Marvin Fouty Date Oct. 5, 1994
Surveyor's Michigan License No. 18989

3. Ronnie M. Lester LS# 18998 used corner in a survey on Oct. 26, 1972 recorded in Liber 1 of Surveys, Page 520 as found boat spike with the following witnesses:
 - Nail and tag south side power pole, NE, 34.62'
 - Nail and tag south side telephone pole, NW, 42.49'
 - Nail and tag north side power pole, SE, 74.76'
4. Ronnie M. Lester LS# 18998 used corner in a survey on March 27, 1973 recorded in Liber 1 of Surveys, Page 728 as set 1/2" bar with same witnesses as item 3.
5. Ronnie M. Lester LS# 18998 used corner in a survey on April 3, 1974 recorded in Liber 1 of Surveys, Page 1221 as set 1/2" bar with same witnesses as item 3.
5. Larry Bryan LS# 25832 reported using the corner in an unrecorded survey in March of 1991 with no record of monument or witnesses. Surveyor Bryan supplied me with his Section breakdown dimensions.
7. The Ingham County Road Commission records revealed an "iron" with the following witnesses:
 - 8" Elm NNW 41.81'
 - Anch. post SW 40.67'
 - TP SSW 49.28'
 - Tw 16", 24" Oak SSW 76.03'
 - Tw 6", 8" Ash SE 73.43'