

FEB 22 1996

LAND CORNER RECORDATION CERTIFICATE

COMMISSION

Filing Requirement of Act 74, Mich. P.A. 1970


For corners in

INGHAM  
LOCKE TOWNSHIP

Located In:

Corner Code #

- 1. Public Land Survey T 4N R 2E D-2
- T \_\_\_\_\_ R \_\_\_\_\_
- T \_\_\_\_\_ R \_\_\_\_\_
- T \_\_\_\_\_ R \_\_\_\_\_
- 2. Property Controlling S \_\_\_\_\_ T \_\_\_\_\_ R \_\_\_\_\_
- in Section S \_\_\_\_\_ T \_\_\_\_\_ R \_\_\_\_\_
- 3. Miscellaneous S \_\_\_\_\_ T \_\_\_\_\_ R \_\_\_\_\_
- Property in Sec. S \_\_\_\_\_ T \_\_\_\_\_ R \_\_\_\_\_
- 4. Lot No. \_\_\_\_\_, Recorded Plat \_\_\_\_\_
- 5. Private Claims \_\_\_\_\_

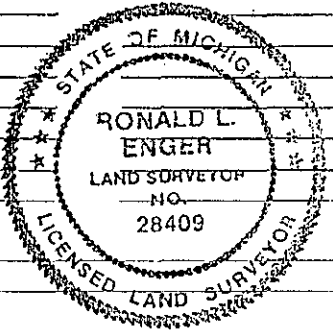

FILED

12/06/1995 08:38:36  
REGISTER OF DEEDS  
PAULA JOHNSON  
INGHAM COUNTY, MI

Register of Deeds Stamp & File Number

I, RONALD L. ENGER, in a field survey on OCTOBER 2, 19 95, do hereby certify that under requirements of P.A. 74, Michigan P.A. of 1970, the corner points mentioned in lines 1 and 2 above were in conformance with regulations and rules therefore as required in the current manual of survey instructions of the United States Department of the Interior, Bureau of Land Management or by a decree of a Court of Law and/or that the corner points mentioned in lines 3, 4 and 5 above were in conformance with the rules of the Michigan Board of Land Surveyors or by a Decree of a Court of Law; established, re-established, monumented, re-monumented, recovered, found as expressed below:

	A	B	C	D	E	F	G	H	I	J	K	L	M
2	6			4	3								
3													
4	7	8	9	10	11	12							
5													
6	16	17	16	15	14	13							
7													
8	19	20	21	22	23	24							
9													
10	30	29	28	27	26	25							
11													
12	31	32	33	34	35	36							
13													

NOTE: Not more than 4 corners, all in the same town and range, may be recorded on this certificate.

A. Description of original monument and accessories and/or subsequent restoration:

- 1. CORNER NOT SET IN ORIGINAL GOVERNMENT SURVEYS.
- 2. T. J. BROWN, DEPUTY COUNTY SURVEYOR, SET CORNER DURING A SURVEY IN SEPTEMBER 1864 RECORDED IN VOLUME 3, PAGE 15 INGHAM COUNTY SURVEY RECORDS WITH NO MENTION OF MONUMENT OR WITNESSES.

CONTINUED ON BACK

B. Description of corner evidence found and/or method applied in restoring or reestablishing corner:

SEARCHED AT APPARENT LOCATION OF CORNER AND FOUND 5/8" BAR AND CAP #28409 IN ANCHOR POST HOLE. ACCEPTED BAR AND CAP AS CORNER BASED ON PREVIOUS TRAVERSE (SEE ITEM A-4) AND ACCORDINGLY SET STANDARD MARKER FOR PA 345 REMONUMENTATION IN INGHAM COUNTY IN ITS PLACE. MEASURED EAST 2612.28' TO E-2. MEASURED SOUTH 2661.00' TO D-3. MEASURED WEST 2616.53' TO C-2. MEASURED NORTH 3827.36 TO D-1. MEASUREMENTS BASED ON M. FOUTY'S TRAVERSE RECORDED IN REMONUMENTATION FIELD BOOK LO-1 AND ENGER SURVEYING TRAVERSE FOR JOB #33-282. BROWN MEASURED NORTH 3807.54 FEET TO D-1, EAST 2614.92 FEET TO E-2, WEST 2597.76 FEET TO C-2

C. Description of monument for corner and accessories established to perpetuate locating the position of the corner:

D-2 T4N R2E  
 3/4" DIAMETER X 24" LONG SMOOTH STEEL BAR AND CAP IMPRINTED "PA 345 PS 28409"  
 NAIL AND TAG PS 28409 IN EAST SIDE OF 4" PIN OAK, 180° NAZ., 1299.73'  
 NAIL AND TAG PS 28409 IN EAST SIDE OF 5" PIN OAK, 181° NAZ., 1415.30'  
 NAIL AND TAG PS 28409 IN EAST SIDE OF 12" OAK, 0° NAZ., 542.73'  
 NAIL AND TAG PS 28409 IN EAST SIDE OF 8" OAK, 0° NAZ., 716.51'  
 1/2" BAR IN WEST SIDE OF TWO TRACK, 90° NAZ., 11.95' (ENGER SURVEYING AND ENGINEERING TRAVERSE POINT.)

Signed by R. L. Enger 28409

OCTOBER 10, 1995

Date

Surveyor's Michigan License No. \_\_\_\_\_

D-2 T4N R2E  
PART A CONTINUED:

3. MARVIN FOUTY, PS #18989, TRAVERSED SECTION DURING REMONUMENTATION EFFORTS OF 1994 AND SET STANDARD BAR AND CAP AT WHAT HE THOUGHT WAS OCCUPIED FENCE CORNER.

4. DAVID CLIFFORD, PS 25837, DURING AN ENGER SURVEYING AND ENGINEERING SURVEY IN APRIL 1995, FOUND FOUTY'S BAR & CAP PA 345 PS 18989 ON NORTH-SOUTH FENCE LINE BUT 5' +/- SOUTH OF ANCHOR POST AT INTERSECTING FENCE LINES. USING FOUTY'S TRAVERSE CLIFFORD DETERMINED THAT FENCE INTERSECTION AND INTERSECTING 1/4 LINES WERE SAME POINT AND SET 5/8" BAR AND CAP LS 28409 (RON ENGER, CLIFFORD'S EMPLOYER) IN ANCHOR POST HOLE.