


LAND CORNER RECORDATION CERTIFICATE
Filing Requirement of Act 74, Mich. P.A. 1970

For corners in
INGHAM
LOCKE TOWNSHIP

Located In: Corner Code ##

- 1. Public Land Survey T 4N R 2E D-4
2. Property Controlling in Section S T R
3. Miscellaneous Property in Sec. S T R
4. Lot No. Recorded Plat
5. Private Claims

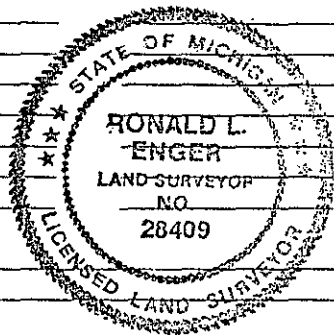

FILED
11/28/1995 09:36:57
REGISTER OF DEEDS
PAULA JOHNSON
INGHAM COUNTY, MI
Register of Deeds Stamp & File Number

Grid table with columns A-L and rows 1-13. Cell C-8 contains the number 8.

I, RONALD L. ENGER, in a field survey on SEPTEMBER 27, 1995, do hereby certify that under requirements of P.A. 74, Michigan P.A. of 1970, the corner points mentioned in lines 1 and 2 above were in conformance with regulations and rules therefore as required in the current manual of survey instructions of the United States Department of the Interior, Bureau of Land Management or by a decree of a Court of Law and/or that the corner points mentioned in lines 3, 4 and 5 above were in conformance with the rules of the Michigan Board of Land Surveyors or by a Decree of a Court of Law; established, re-established, monumented, re-monumented, recovered, found as expressed below:

NOTE: Not more than 4 corners, all in the same town and range, may be recorded on this certificate.

A. Description of original monument and accessories and/or subsequent restoration:

1. CORNER NOT SET IN ORIGINAL GOVERNMENT SURVEY.

2. L. BRYAN, PS #25832 RECORDED CORNER IN LIBER 6, PAGE 324 IN APRIL 1987 AS "SET 1/2" BAR AND CAP ON NORTH-SOUTH 1/4 LINE OPPOSITE FENCE LINES EAST AND WEST", WITH THE FOLLOWING WITNESSES:
NAIL AND TAG SOUTH SIDE POWER POLE, WEST, 44.38'
NAIL AND TAG NORTHWEST SIDE 8" TWIN MAPLE, N45°E, 83.34'
SOUTHWEST CORNER HOUSE, N70°E, 133.71'
CONTINUED ON BACK.

B. Description of corner evidence found and/or method applied in restoring or reestablishing corner:

SEARCHED AT APPARENT LOCATION OF CORNER AND FOUND 3/4" BAR AND PA 345 PS 18989 CAP IN MONUMENT BOX ON EAST-WEST FENCE LINE IN WEST LANE OF PRINGLE ROAD. AS THERE IS NO RECORD OF COUNTY SURVEYOR ACTIVITY IN THIS SECTION AND NO WAY TO ASCERTAIN THE ORIGIN OF THE EAST-WEST FENCE, I DO NOT AGREE THAT THE EAST-WEST FENCE IS EVIDENCE OF AN EARLIER ESTABLISHMENT OF CENTER OF SECTION BY A SURVEYOR. THEREFORE I REJECT L. BRYAN'S ESTABLISHMENT (ITEM A-2) AND ESTABLISH THE CORNER AT THE INTERSECTION OF THE 1/4 LINES. SET STANDARD MARKER FOR PA 345 REMONUMENTATION IN INGHAM COUNTY TO MONUMENT CORNER. MEASURED NORTH 2632.46' TO D-3. MEASURED SOUTH 2612.36' TO D-5. MEASURED WEST 2621.95 TO C-4. MEASURED EAST 2623.92 TO E-4. MEASUREMENTS ARE BASED ON M. FOUTY'S TRAVERSE IN REMONUMENTATION FIELD BOOK LO-1.

C. Description of monument for corner and accessories established to perpetuate locating the position of the corner:
D-4 T4N R2E

3/4" DIAMETER X 24" LONG SMOOTH STEEL BAR AND CAP IMPRINTED "PA 345 PS 28409".
1/2" BAR IN MONUMENT BOX 4° NAZ., 29.73'
NAIL AND TAG PS 28409 IN EAST SIDE OF 6" OAK, 345° NAZ., 62.60'
NAIL AND TAG PS 28409 IN EAST SIDE OF 5" OAK, 354° NAZ., 86.54'
NAIL AND TAG PS 28409 IN WEST SIDE OF MULTIPLE TRUNK MAPLE, 25° NAZ., 110.58'
NAIL AND TAG PS 28409 IN NORTHWEST SIDE OF ANCHOR POST, 50° NAZ., 39.54'
CORNER IS 5' WEST OF CENTERLINE OF PRINGLE ROAD AND 30' SOUTH OF FENCES TO EAST AND WEST.

Signed by [Signature] Date OCTOBER 11, 1995

Surveyor's Michigan License No. 28409

D-4 T4N R2E
PART A CONTINUED:

3. L. BRYAN PS #25832 IN FIELD TRAVERSE FOR UNRECORDED SURVEY SHOWS CORNER BEING SET ON NORTH-SOUTH 1/4 LINE AND FENCE LINE EAST-WEST AND THEN STATES THAT INTERSECTION OF 1/4 LINES SHOULD BE 30' SOUTH. L. BRYAN THEN SET EAST 1/4 CORNER 80.64' SOUTH OF FENCE INTERSECTION MAKING A 1° 17' DEFLECTION OF THE EAST-WEST 1/4 LINE AT THE CENTER OF SECTION IF LEFT AS IS.
4. 1994 PA 345 MONUMENTATION SURVEYOR MARVIN FOUTY, PS 18989, REPORTED FINDING CAPPED IRON #25832 6' WEST OF CENTERLINE PRINGLE ROAD ON MARCH 28, 1994 (BOOK LO1, PAGE 2) AND AGAIN ON OCTOBER 20, 1994 (BOOK LO1, PAGE 7).