

LAND CORNER RECORDATION CERTIFICATE  
Filing Requirement of Act 74, Mich. P.A. 1970

For corners in

INGHAM


(County)

LOCKE TOWNSHIP

Located In:

Corner Code #

- 1. Public Land Survey T 4N R 2E E-1
- T \_\_\_\_\_ R \_\_\_\_\_
- T \_\_\_\_\_ R \_\_\_\_\_
- T \_\_\_\_\_ R \_\_\_\_\_
- 2. Property Controlling S \_\_\_\_\_ T \_\_\_\_\_ R \_\_\_\_\_
- in Section S \_\_\_\_\_ T \_\_\_\_\_ R \_\_\_\_\_
- 3. Miscellaneous S \_\_\_\_\_ T \_\_\_\_\_ R \_\_\_\_\_
- Property in Sec. S \_\_\_\_\_ T \_\_\_\_\_ R \_\_\_\_\_
- 4. Lot No. \_\_\_\_\_, Recorded Plat \_\_\_\_\_
- 5. Private Claims \_\_\_\_\_

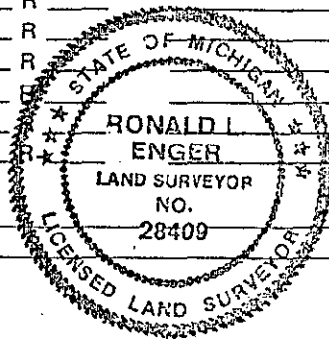

FILED

11/28/1995 09:36:51  
REGISTER OF DEEDS  
PAULA JOHNSON  
INGHAM COUNTY, MI

Register of Deeds Stamp & File Number

	A	B	C	D	E	F	G	H	I	J	K	L
2	6		5		4		3		2		1	
3												
4	7		8		9		10		11		12	
5												
6	18		17		16		15		14		13	
7												
8	19		20		21		22		23		24	
9												
10	30		29		28		27		26		25	
11												
12	31		32		33		34		35		36	

I, RONALD L. ENGER, in a field survey on OCTOBER 2, 19 95

do hereby certify that under requirements of P.A. 74, Michigan P.A. of 1970, the corner points mentioned in lines 1 and 2 above were in conformance with regulations and rules therefore as required in the current manual of survey instructions of the United States Department of the Interior, Bureau of Land Management or by a decree of a Court of Law and/or that the corner points mentioned in lines 3, 4 and 5 above were in conformance with the rules of the Michigan Board of Land Surveyors or by a Decree of a Court of Law; established, re-established, monumented, re-monumented, recovered, found as expressed below:

NOTE: Not more than 4 corners, all in the same town and range, may be recorded on this certificate.

A. Description of original monument and accessories and/or subsequent restoration:

1. POST SET IN ORIGINAL GOVERNMENT SURVEY BY J. WAMPLER, DEPUTY SURVEYOR IN MARCH 1826 WITH THE FOLLOWING NOTATION IN THE FIELD NOTES:  
"INTERSECTED TOWNSHIP LINE 47 LKS (31.02') EAST IN MARSH"  
TAM 10" S6E 187  
NO OTHER

CONTINUED ON BACK

B. Description of corner evidence found and/or method applied in restoring or reestablishing corner:  
SEARCHED AT APPARENT LOCATION OF CORNER AND FOUND 3/4" BAR AND PA345 CAP PS 18989 ON NORTH SLOPE OF DITCH BANK 6' EAST OF FENCE TO NORTH AND 59' WEST OF FENCE TO SOUTH. FOUND 1/2" BAR AND CAP #25832 (LARRY BRYAN) IN OLD ANCHOR POST 10' NORTH AND 6' WEST OF FOUND 3/4" BAR AND CAP. FOUND ANOTHER 1/2" BAR ON EAST SIDE OF THIS ANCHOR POST. FOUND RING OF STONES 65' EAST OF THIS ANCHOR POST. RING OF STONES IS ON NORTH SIDE OF DITCH AT NORTH END OF FENCE TO SOUTH. TIED LOCATION OF FENCE TO NORTH AND FENCE TO SOUTH. FENCE TO NORTH IS STRAIGHT TO 1/4 CORNER 1/2 MILE NORTH IN LOCKE ROAD. FENCE TO SOUTH IS NOT. AT LEAST THREE SPOTS ON FENCE TO SOUTH HAVE LARGE JOGS IN ALIGNMENT, ONE OF WHICH IS ALMOST 50'. THE FIELD TRAVERSE OF SECTION 5 REVEALS A GOOD PRORATION OF T. J. BROWN'S SURVEY OF 1864 IF E-1 IS LOCATED AT 31.1' EAST OF THE FOUND IRONS AT THE ANCHOR POST OF FENCE TO NORTH.

CONTINUED ON BACK

C. Description of monument for corner and accessories established to perpetuate locating the position of the corner:

E-1 T4N R2E  
3/4" DIAMETER X 24" LONG SMOOTH STEEL BAR AND CAP IMPRINTED "PA 345 PS 28409" IN EAST-WEST FENCE LINE.  
1/2" BAR AND CAP #25832 (E-13 PERRY TOWNSHIP), 270° NAZ., 31.10'  
SET 20D GALV SPIKE & TAG PS 28409 IN NORTH SIDE 10" OAK, 265° NAZ., 37.45'  
SET 20D GALV SPIKE & TAG PS 28409 IN EAST SIDE 37" POPLAR, 339° NAZ., 5.32'  
SET 20D GALV SPIKE & TAG PS 28409 IN EAST SIDE 33" POPLAR, 354° NAZ., 12.26'  
SET 20D GALV SPIKE & TAG PS 28409 IN SOUTH SIDE 6" HICKORY, 288° NAZ., 20.45'

Signed by Ronald L Enger Date OCTOBER 8, 1995  
28409

Surveyor's Michigan License No. \_\_\_\_\_

E-1 T4N R2E  
PART A CONTINUED:

2. T. J. BROWN, DEPUTY COUNTY SURVEYOR, USED CORNER IN A SURVEY RECORDED IN VOLUME 3, PAGE 15 COUNTY SURVEYOR RECORDS IN SEPTEMBER 1864 AS "A POST FROM WHICH A LOW TAMARAC STUMP SAY 10" IN DIAMETER BEARS S90°E 187 LINKS (THIS IN MARSH)".
3. O. M. ELLIOT, SHIAWASSEE COUNTY SURVEYOR IN FIELD BOOK 20, PAGE 34 DATED JULY 29, 1950 CALLS FOR E-13 PERRY TOWNSHIP TO BE IRON ON NORTH BANK OF DITCH.
4. RONNIE LESTER, PS 18998 SET 1/2" BAR AND CAP AT THE GLO FALLING OF 31.10' EAST OF E-13 PERRY TOWNSHIP WHICH WAS SET BY SINGLE PROPORTIONATE MEASUREMENT DURING THE INGHAM COUNTY REMONUMENTATION PROJECT OF THE LATE 1970'S AND EARLY 1980'S WITH THE FOLLOWING WITNESSES:  
1/2" BAR AND CAP AT E-13 PERRY TOWNSHIP, WEST 31.10'  
NAIL AND TAG 18998 IN SOUTH SIDE OF 4 TRUNK 10" MAPLE, N80°W 11.74'  
NAIL AND TAG 18998 IN NORTH SIDE OF 10" ELM, DUE WEST 3.70'  
NAIL AND TAG 18998 IN NORTH SIDE OF 10" ELM, EAST 5.53'
5. 1994 PA 345 MONUMENTATION SURVEYOR, MARVIN FOUTY, PS 18989, REMONUMENTED LESTER'S E-1 POSITION WITH A 3/4" BAR AND PA 345 PS 18989, AND MADE FOUR WITNESSES OCTOBER 20, 1994, BOOK LO-1, PAGE 8.

PART B CONTINUED:

BASED ON THIS AND THE UNRELIABILITY OF FENCE TO SOUTH, I ACCEPT THE ANCHOR POST FOR THE FENCE TO THE NORTH (WHICH I ACCEPT AS THE BEST EVIDENCE OF THE LOCATION FOR E-13, PERRY, IN AGREEMENT WITH SURVEYOR BRYAN) AND THE GLO FALLING AS THE BEST EVIDENCE OF THE ORIGINAL GOVERNMENT POSITION FOR THIS CORNER AND ACCORDINGLY SET STANDARD MARKER FOR PA 345 REMONUMENTATION IN INGHAM COUNTY ON THE STANDARD TOWNSHIP LINE 31.10' EAST OF BRYAN'S MARKER AT E-13. (USED BRYAN'S MARKER AT E-13 AND 1 1/2" PIPE AT G-13 AS THE TOWNSHIP LINE.) MEASURED SOUTH 3890.56' TO E-2. MEASURED WEST 2615.97' TO D-1. MEASUREMENTS BASED ON M. FOUTY TRAVERSE RECORDED IN REMONUMENTATION FIELD BOOK LO-1 AND ENGER SURVEYING TRAVERSE FOR JOB #33-282. R. LESTER MEASURED 5252.07 FEET EAST FROM THE ANCHOR POST AT E-13 TO G-13 IN 1981. REMOVED FOUTY'S 3/4" BAR AND PA 345 CAP.