

LAND CORNER RECORDATION CERTIFICATE
Filing Requirement of Act 74, Mich. P.A. 1970


For corners in
INGHAM
(County)
LOCKE TOWNSHIP

Located In: Corner Code #

E-2

EILED
11/28/1995 09:36:52
REGISTER OF DEEDS
PAULA JOHNSON
INGHAM COUNTY, MI

- 1. Public Land Survey T 4N R 2E E-2
2. Property Controlling in Section S T R
3. Miscellaneous Property in Sec. S T R
4. Lot No. Recorded Plat
5. Private Claims

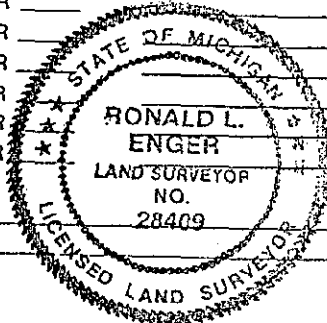

Register of Deeds Stamp & File Number

Grid table with columns A-L and rows 2-13. A dot is marked at the intersection of column E and row 5.

I, RONALD L. ENGER in a field survey on OCTOBER 2, 1995 do hereby certify that under requirements of P.A. 74, Michigan P.A. of 1970, the corner points mentioned in lines 1 and 2 above were in conformance with regulations and rules therefore as required in the current manual of survey instructions of the United States Department of the Interior, Bureau of Land Management or by a decree of a Court of Law and/or that the corner points mentioned in lines 3, 4 and 5 above were in conformance with the rules of the Michigan Board of Land Surveyors or by a Decree of a Court of Law; established, re-established, monumented, re-monumented, recovered, found as expressed below:

NOTE: Not more than 4 corners, all in the same town and range, may be recorded on this certificate.

A. Description of original monument and accessories and/or subsequent restoration:

1. POST SET IN ORIGINAL GOVERNMENT SURVEY BY J. WAMPLER, DEPUTY SURVEYOR IN MARCH 1826 AND TWO BEARING TREES RECORDED:
ASH 8" S4°W 93 (61.4')
DO 12" S35°E 96 (63.4')

CONTINUED ON BACK.

B. Description of corner evidence found and/or method applied in restoring or reestablishing corner:

SEARCHED AT APPARENT LOCATION OF CORNER AND FOUND 3/4" BAR AND PA 345 CAP PS 18989 IN CIRCLE OF STONES AT ANCIENT ANCHOR POST. MEASURED WEST ALONG FENCE ROW TO 3 LARGE ELM STUMPS AT 126.5', 129.5' AND 134.5'. ACCEPTED BAR AND CAP AT ANCHOR POST AS CORNER AS PERPETUATED BY WILLIAM BERRYMAN. LEFT 3/4" BAR IN PLACE AND REPLACED CAP WITH PA 345 CAP PS 28409. CONCLUDED THAT M. FOUTY'S POINT LO1-29-E2-34 IS THIS LOCATION. MEASURED NORTH 3890.60 TO E-1. MEASURED WEST 2612.28 TO D-2. MEASURED SOUTH 2668.68 TO E-3. MEASUREMENTS BASED ON M. FOUTY'S TRAVERSE RECORDED IN REMONUMENTATION FIELD BOOK LO-1 AND ENGER SURVEYING TRAVERSE FOR JOB #33-282.

C. Description of monument for corner and accessories established to perpetuate locating the position of the corner:

E-2 T4N R2E
3/4" DIAMETER X 24" LONG SMOOTH STEEL BAR AND CAP IMPRINTED "PA 345 PS 28409"
NAIL AND CAP 18989 IN WEST SIDE OF 10" ELM, 356° NAZ., 5.50'
NAIL AND CAP 18989 IN WEST SIDE OF 16" ELM, 167° NAZ., 10.70'
NAIL AND TAG 28409 IN WEST SIDE OF 16" ELM, 210° NAZ., 17.25'
NAIL AND CAP 18989 IN SOUTH SIDE OF 12" ELM, 263° NAZ., 31.00'

Signed by [Signature] Date OCTOBER 10, 1995
Surveyor's Michigan License No. 28409

E-2 T4N R2E
PART A CONTINUED:

2. T. J. BROWN, DEPUTY COUNTY SURVEYOR, USED CORNER IN A SURVEY DATED SEPTEMBER 2, 1864 AND RECORDED IN PAGE 15, VOLUME 3 COUNTY SURVEYOR RECORDS AS A POST FROM WHICH AN ELM 16 INCH DIAMETER BEARS S17E 83 LKS (54.8') AND A BLACK ASH 12 INCH DIAMETER BEARS S8W 93 LKS (61.4').

3. THE PERSONAL NOTES OF WILLIAM BERRYMAN, FORMER COUNTY SURVEYOR, CALL FOR CORNER AS AN ANCHOR POST WITH THE FOLLOWING WITNESSES:
ELM W 126.5'
ELM W 129.3'
DOUBLE ELM W 134.3'

4. 1994 PA 345 MONUMENTATION SURVEYOR MARVIN FOUTY, PS 18989 IN BOOK LO-1, PAGE 8 NOTES "RE-SET #18989" AND SHOWS FOUR WITNESSES (DATED 20 OCTOBER 1994) AND ON PAGE 29 (DATED 21 SEPTEMBER 1994) MADE TRAVERSE TIE TO AN UNDESCRIBED MARKER (OR LOCATION), POINT NUMBER LO1-29-E2-34.

