

**SURVEY &
REMONUMENTATION**

JAN 18 2001

SECTION

LAND CORNER RECORDATION CERTIFICATE
Filing Requirement of Act 74, Mich. P.A. 1970

For corners in

INGHAM COUNTY Located In: _____ Corner Code # _____
(County)
LOCKE TOWNSHIP
1. Public Land Survey T 4N R 2E E-3
T _____ R _____
T _____ R _____
T _____ R _____
2. Property Controlling S _____ T _____ R _____
in Section S _____ T _____ R _____
3. Miscellaneous S _____ T _____ R _____
Property in Sec. S _____ T _____ R _____

Paula Johnson
INGHAM COUNTY
REGISTER OF DEEDS
ENGER SURVEYING

L-10 P-73
RECORDED CRNR 9.00 2000-048337
2000-048337
Page: 1 of 1
11/14/2000 08:41A

Register of Deeds Stamp & File Number

4. Lot No. _____, Recorded Plat _____
5. Private Claims _____

	A	B	C	D	E	F	G	H	I	J	K	L	M
1													
2	6		5		4		3		2		1		
3					●								
4	7		8		9		10		11		12		
5													
6	18		17		16		15		14		13		
7													
8	19		20		21		22		23		24		
9													
10	30		29		28		27		26		25		
11													
12	31		32		33		34		35		36		
13													

I, DAVID L. CLIFFORD, in a field survey on OCTOBER 8, 1996
Do hereby state that under requirements of P.A. 74, Michigan P.A. of 1970, the corner points mentioned in lines 1 and 2 above were in conformance with regulations and rules therefore as required in the current manual of survey instructions of the United States Department of the Interior, Bureau of Land Management or by a decree of a Court of Law and for that the corner points mentioned in lines 3, 4 and 5 above were in conformance with the rules of the Michigan Board of Land Surveyors or by a Decree of a Court of Law, established, re-established, monumented, recovered, found as expressed below:

NOTE: Not more than 2 corners, all in the same town and range, may be recorded on this certificate.

A. Description of original monument and accessories and/or subsequent restoration:

- POST SET IN ORIGINAL GOVERNMENT SURVEY BY JOSEPH WAMPLER, DEPUTY SURVEYOR IN MARCH 1826: ELM 12" S22E 34; ELM 12" S22E 34
- JOHN MCCREARY, COUNTY SURVEYOR, SURVEYED THE LOOKING GLASS DRAIN IN JUNE 1896 AND THE MINUTES OF THIS SURVEY SHOW SAID DRAIN TO BE ON THE LINE BETWEEN THE EAST 1/2 AND THE WEST 1/2 OF THE SW 1/4 OF SECTION 4 T4N R2E
- R. LESTER, PS #18998, RECORDED CORNER IN LIBER 2 OF CORNERS, PAGE 455 IN JUNE 1973 AND USED IT IN AN ACT 132 SURVEY RECORDED IN LIBER 1 PAGE 797 AS A "SET 1/2" BAR IN CENTERLINE OF COLBY ROAD AT PRORATED GOVERNMENT MEASUREMENT", WITH THE FOLLOWING WITNESSES: NAIL AND TAG SOUTH SIDE 24" TREE, WNW, 213.40'; NAIL AND TAG SOUTH SIDE 24" OAK, ENE, 156.92'; SOUTHWEST CORNER BRICK HOUSE #3501, NE, 164.94
- 1994 PA 345 MONUMENTATION SURVEYOR MARVIN FOUTY, PS 18989, BOOK LO-1, PAGE 3 NOTES "FOUND 1/2" IRON BAR AT 1' SOUTH OF PHYSICAL CENTERLINE OF COLBY ROAD AND SHOWS FOUR WITNESSES; FOUND NAIL & TAG 25832 E. FACE 18" TREE N40°W 69.34'; FOUND NAIL & TAG 25832 S. FACE 34" OAK N82°E 157.06'; SET NAIL & TAG #18989 SE SIDE 14" TREE S55°W 33.00'; SW COR BRICK FASCIA OF HSE # 3501 N36°E 164.94' (DATED 28 MARCH 1994).

B. Description of corner evidence found and/or method applied in restoring or reestablishing corner:


SEARCHED AT APPARENT LOCATION OF CORNER AND FOUND 3/4" BAR AND PA 345 PS 18989 CAP IN MONUMENT BOX MATCHING LESTER'S 1973 WITNESSES AND FOUTY'S 1994 WITNESSES. TIED LOCATION OF 1/4 CORNER AND 1/16 LINE FENCES TO EAST AND WEST AND THESE DID NOT MATCH LOCATION OF RECORDED CORNER. EXCAVATED 4' X 4' HOLE, CENTERED ON POINT 16' WEST OF RECORDED CORNER AND ON CENTERLINE OF COLBY ROAD, THROUGH 18" OF GRAVEL INTO NATURAL GROUND. IN WEST EDGE OF HOLE FOUND 2' X 10" X 8" GRANITE STONE LYING ON SIDE. ACCEPTED STONE AS CORNER BASED ON AGREEMENT WITH OCCUPATION LINES AND SET STANDARD MARKER FOR PA 345 REMONUMENTATION IN INGHAM COUNTY AT BASE AND PLACED STONE ON NORTH SIDE OF BAR. MEASURED NORTH 2668.68' TO E-2. MEASURED WEST 2616.00' TO D-3 AND WEST 1309.2' TO 1/16 LINE OCCUPATION. MEASURED WEST 5227.64' TO C-3. THE GLO MEASUREMENT TO C-3 WAS 5227.2'. MEASURED SOUTH 2631'+ TO E-4. MEASURED EAST 2674.29' TO F-3 AND EAST 1336.65' TO 1/16 LINE OCCUPATION (LOOKING GLASS DRAIN). GLO MEASUREMENT TO F-3 WAS 2630.10'. MEASUREMENTS BASED ON M. FOUTY'S TRAVERSE OF SECTION 5 IN FIELD BOOK LO1 AND ENGER SURVEYING MEASUREMENTS IN BOOK LO1 PAGES 41 AND 47. AT THE DIRECTION OF THE PEER REVIEW GROUP RETURNED TO CORNER ON OCTOBER 8, 1996 AND EXCAVATED 4' X 6' X 4' DEEP HOLE CENTERED ON STONE. STONE WAS LYING IN A 1' CLAY LAYER BENEATH 18" GRAVEL ABOVE A CORDUROY ROAD. THIS SURVEYOR STILL BELIEVES THAT STONE MARKS THE POSITION OF THE PERPETUATED LOCATION OF THE CORNER (PROBABLY BY COUNTY SURVEYOR MCCREARY) BASED ON MEASUREMENTS TO OCCUPATION LINES AT 1/4 LINE AND 1/16 LINE TO EAST AND WEST. LEFT STANDARD MONUMENT IN THE SAME POSITION AS PLACED IN 1994.

C. Description of monument for corner and accessories established to perpetuate locating the position of the corner:

E-3 T4N R2E
3/4" X 24" SMOOTH STEEL BAR & YELLOW PLASTIC CAP IMPRINTED PA 345 PS 25837
SW CORNER BRICK HOUSE, N50°E, 175.41'
CENTER OF 14" MAPLE TREE, N67°E, 121.68'
FOUND NAIL AND TAG #25832 (LARRY BRYAN) IN SOUTH SIDE OF 36" OAK, EAST, 174.00'
FOUND NAIL AND TAG #28409 (RON ENGER) IN EAST SIDE OF 14" POPLAR, S37°W, 21.19'
3/4" BAR (IN POSITION RECORDED IN LIBER 2 OF CORNERS, PAGE 455) IN MONUMENT BOX, S85°E, 17.11'

Signed by David L. Clifford
Surveyor's Michigan License No. 25837

Date OCTOBER 02, 2000

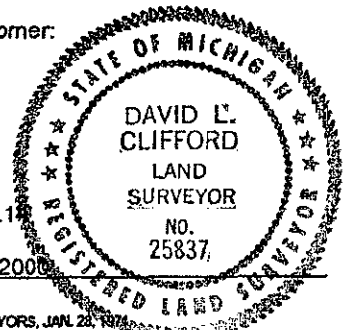

FORM APPROVED BY MICHIGAN STATE BOARD OF PROFESSIONAL SURVEYORS, JAN. 28, 1978
REVISED MAY 14, 1975

REVISED JAN, 1983
REVISED OCT, 1996

P.A. 345 INGHAM COUNTY
PEER APPROVED 10/3/2000 RL