


LAND CORNER RECORDATION CERTIFICATE
Filing Requirement of Act 74, Mich. P.A. 1970

For corners in INGHAM LOCKE TOWNSHIP

Located In: Corner Code #

- 1. Public Land Survey T 4N R 2E E-4
2. Property Controlling in Section S T
3. Miscellaneous Property in Sec. S T
4. Lot No. Recorded Plat
5. Private Claims

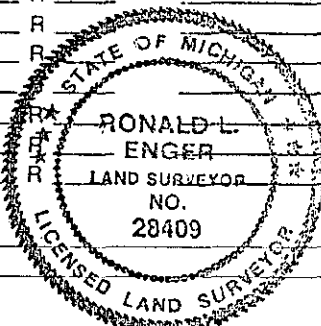

FILED 11/28/1995 09:36:54 REGISTER OF DEEDS PAULA JOHNSON INGHAM COUNTY, MI Register of Deeds Stamp & File Number

Grid table with columns A-L and rows 1-13. A dot is present at row 4, column E.

RONALD L. ENGER SEPTEMBER 27 1995
I, in a field survey on, do hereby certify that under requirements of P.A. 74, Michigan P.A. of 1970, the corner points mentioned in lines 1 and 2 above were in conformance with regulations and rules therefore as required in the current manual of survey instructions of the United States Department of the Interior, Bureau of Land Management or by a decree of a Court of Law and/or that the corner points mentioned in lines 3, 4 and 5 above were in conformance with the rules of the Michigan Board of Land Surveyors or by a Decree of a Court of Law; established, re-established, monumented, re-monumented, recovered, found as expressed below:

NOTE: Not more than 4 corners, all in the same town and range, may be recorded on this certificate.

A. Description of original monument and accessories and/or subsequent restoration:

1. POST SET IN ORIGINAL GOVERNMENT SURVEY BY JOSEPH WAMPLER, DEPUTY SURVEYOR IN MARCH 1826 AND TWO BEARING TREES RECORDED: ELM 9 S3E 15 DO 9 S82E 11

CONTINUED ON BACK

B. Description of corner evidence found and/or method applied in restoring or reestablishing corner:

SEARCHED AT APPARENT LOCATION OF CORNER AND FOUND 3/4" SMOOTH BAR IN RING OF STONES AT ANCHOR POST. ALSO FOUND 1/2" BAR AND CAP #25832 IN NORTH-SOUTH FENCE LINE ABOUT 80' SOUTH OF THE ANCHOR POST AND PROVED IT TO BE IN POSITION SET BY L. BRYAN'S SECOND LCRC (ITEM A-3) BY THE ASH IN THE NORTHEAST QUAD AND THE DISTANCES TO E-3 AND E-5.) AS THERE IS NO RECORD OF COUNTY SURVEYOR ACTIVITY IN THIS SECTION AND NO WAY TO ASCERTAIN THE ORIGIN OF THE EAST-WEST FENCE, I AGREE WITH SURVEYOR BRYAN THAT THE CORNER IS OBLITERATED AND WITH HIS RE-ESTABLISHMENT AS DESCRIBED IN HIS SECOND LCRC (ITEM A-3). ACCORDINGLY SET STANDARD MARKER FOR PA 345 REMONUMENTATION IN INGHAM COUNTY IN PLACE OF BRYAN'S 1/2" BAR. MEASURED SOUTH 2630'+- TO E-5. MEASURED NORTH 2630'+- TO E-3. MEASURED WEST 2623.92 TO D-4. MEASUREMENTS BASED ON M. FOUTY'S TRAVERSE RECORDED IN REMONUMENTATION FIELD BOOK LO-1 AND ENGER SURVEYING LOCATION OF D-4 ON PAGE 44 OF LO-1.

C. Description of monument for corner and accessories established to perpetuate locating the position of the corner:

E-4 T4N R2E
3/4" DIAMETER X 24" LONG SMOOTH STEEL BAR AND CAP IMPRINTED "PA 345 PS 28409", NAIL AND TAG 28409 IN EAST SIDE OF 48" TRIPLE TRUNK MAPLE, 17° NAZ., 12.06'
NAIL AND TAG 28409 IN EAST SIDE OF 15" ASH, 19° NAZ., 24.62'
NAIL AND TAG 28409 IN WEST SIDE OF 8" MAPLE, 330° NAZ., 26.14'
NAIL AND TAG 28409 IN NORTHWEST SIDE OF 6" MAPLE, 203° NAZ., 6.76'

Signed by [Signature] Date OCTOBER 10, 1995
Surveyor's Michigan License No. 28409

E-4 T4N R2E
PART A CONTINUED:

2. L. BRYAN, PS #25832, RECORDED CORNER IN APRIL 17, 1987 IN LIBER 6 OF CORNERS, PAGE 324, AS A "SET 1/2" BAR AND CAP IN CENTERLINE OF OLD POST AND CIRCLE OF STONES..." WITH THE FOLLOWING WITNESSES:
NAIL AND TAG WEST SIDE 5" OAK, NORTH, 4.11'
NAIL AND TAG NORTH SIDE 6" ELM, WEST, 17.83'
NAIL AND TAG SOUTHWEST SIDE 8" OAK, N60°W, 17.26'
3. L. BRYAN RECORDED CORNER IN MARCH 1991 IN LIBER 7 OF CORNERS, PAGE 221, 80' SOUTH OF LOCATION AS RECORDED IN LIBER 6, PAGE 324. "SET 1/2" BAR AND CAP MIDWAY BETWEEN THE NORTHWEST AND SOUTHWEST CORNERS OF SECTION 9 IN A NORTH-SOUTH FENCE LINE", WITH THE FOLLOWING WITNESSES:
NAIL AND TAG EAST SIDE 10" ASH, N30°E, 24.40'
NAIL AND TAG WEST SIDE 6" BEECH, S40°E, 14.00'
NAIL AND TAG NORTH SIDE 8" OAK, N75°W, 15.20'
4. 1994 PA 345 MONUMENTATION SURVEYOR MARVIN FOUTY, PS #18989, EXCAVATED AT L. BRYAN'S FIRST RECORDED POSITION AND CONFIRMED EXISTENCE OF STONES AND OLD ANCHOR POST BUT DID NOT FIND BRYAN'S MARKER, SO SET 3/4" X 24" BAR IN ANCHOR POST AND IN APPROXIMATE AGREEMENT WITH BRYAN'S WITNESSES. TIED SET BAR INTO TRAVERSE, POINT NO. LO1-26-E4-31.