

SURVEY &
REMONUMENTATION

DEC 16 1996

COMMISSION

LAND CORNER RECORDATION CERTIFICATE
Filing Requirement of Act 74, Mich. P.A. 1970

Liber 9 Page 53


For corners in
INGHAM
(County)

Located In: LOCKE TOWNSHIP
Corner Code ##


FILED

960043084
11/08/1996 14:28:48
REGISTER OF DEEDS
Paula Johnson
INGHAM COUNTY, MI

- | | | |
|---------------------------------------|-------------------------|------|
| 1. Public Land Survey | T <u>4N</u> R <u>2E</u> | E-11 |
| | T _____ R _____ | |
| | T _____ R _____ | |
| | T _____ R _____ | |
| 2. Property Controlling in Section | S _____ T _____ R _____ | |
| | S _____ T _____ R _____ | |
| 3. Miscellaneous Property in Sec. | S _____ T _____ R _____ | |
| | S _____ T _____ R _____ | |
| 4. Lot No. _____, Recorded Plat _____ | | |
| 5. Private Claims _____ | | |

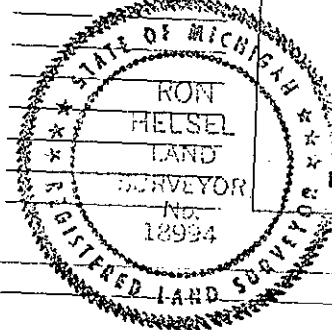

Register of Deeds Stamp & File Number

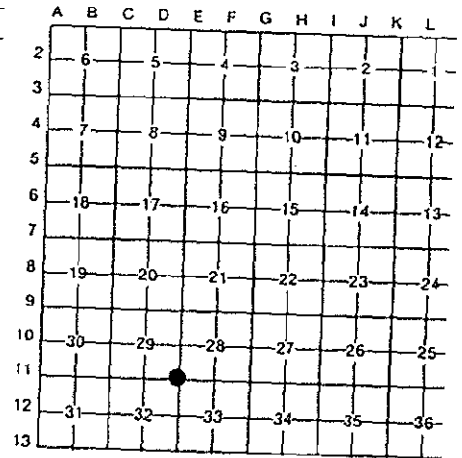

I, RON HELSEL, in a field survey on SEPTEMBER 30, 1996 do hereby certify that under requirements of P.A. 74, Michigan P.A. of 1970, the corner points mentioned in lines 1 and 2 above were in conformance with regulations and rules therefore as required in the current manual of survey instructions of the United States Department of the Interior, Bureau of Land Management or by a decree of a Court of Law and/or that the corner points mentioned in lines 3, 4 and 5 above were in conformance with the rules of the Michigan Board of Land Surveyors or by a Decree of a Court of Law; established, re-established, monumented, re-monumented, recovered, found as expressed below:

NOTE: Not more than 4 corners, all in the same town and range, may be recorded on this certificate.

A. Description of original monument and accessories and/or subsequent restoration:
ORIGINAL MONUMENT: POST SET BY J. WAMPLER, U.S. DEPUTY SURVEYOR, MARCH 1826.
SUGAR 8", S88W, 17 LINKS
BEECH 9", N28W, 4 1/2 LINKS
1) VOL. 2, PAGE 156, AUG. 29, 1853 AND VOL. 2, PAGE 158, AUG. 31, 1853, COUNTY SURVEYOR A. JACKSON CITED THE ORIGINAL BEARING TREES.
2) A L.C.R.C. WAS RECORDED IN LIBER 3, PAGE 223, FIELD DATED JULY 15, 1974 BY J. STEPHENS NO. 16053 "AN IRON PIPE WAS SET IN THE CENTERLINE OF DIETZ ROAD, ON A PROJECTION OF FENCE LINES EAST AND WEST OF THE CORNER."
CONTINUED ON BACK

B. Description of corner evidence found and/or method applied in restoring or reestablishing corner:
FOUND THE "T" BAR DESCRIBED BY HUGHES AND (2) OF 3 BEARING TREES RECORDED BY STEPHENS. EXCAVATED AN 8' (EAST-WEST) BY 4.5' (NORTH-SOUTH) HOLE AROUND THE "T" BAR DOWN 6" INTO THE OLD CLAY ROAD BED. FOUND A BRYAN BAR & CAP 33' WEST OF THE "T" BAR IN AN OLD ANCHOR POST HOLE. ACCEPTED THE POSITION OF THE "T" BAR AS FAITHFUL PERPETUATION OF THE CORNER AFTER A DISCUSSION WITH SURVEYOR STEPHENS.

C. Description of monument for corner and accessories established to perpetuate locating the position of the corner:
SET 3/4" X 24" FORM PIN AND CAP LABELED P.A. 345, P.S. NO. 18994 IN CENTERLINE OF DIETZ ROAD. 8" BELOW GRAVEL SURFACE SET NAIL & TAG NO. 18994 E/SIDE 40" MAPLE AZ. 351°, 147.40'
FOUND NAIL & TAG NO. 19834 W/SIDE 12" WALNUT AZ. 42°, 34.14'
SET NAIL & TAG NO. 18994 OVER NAIL & TAG #16053, W/SIDE 18" WALNUT, AZ. 165°, 59.87'
FOUND NAIL & TAG NO. 19834 E/SIDE 15" WALNUT AZ. 202°, 73.27'
FOUND BRYAN BAR & CAP #25832 AZ. 274°, 33.11' IN ANCHOR POST HOLE
HUGHES DISTANCE E-11 TO D-11 2611.46'
HUGHES DISTANCE E-11 TO E-12 2624.02'

Signed by Ron Helsel Date OCTOBER 12 1996
Surveyor's Michigan License No. 18994

"A" CONTINUED

SURVEY TAGS AND NAILS IN:

EAST SIDE OF A 30" MAPLE TREE, N8°52'W, 147.43' (FOUND TREE)

SOUTH SIDE OF A 22" WALNUT TREE, S82°31'E, 36.40' (GONE)

WEST SIDE OF A 24" WALNUT TREE, S17°42'E, 59.87' (FOUND 18" WALNUT)

- 3) AN UNRECORDED SURVEY BY D.D. HUGHES P.S. NO. 19834 DATED 5-17-90,
JOB NO. 90653A-B-C & D
"FOUND "T" IRON 12" BELOW GRADE AT CENTERLINE DIETZ RD. IN LINE WITH
E/W FENCE TO W."
043 DEG. SET NAIL/TAG NW/S 12" ELM (FOUND WALNUT)
164 DEG. FD. NAIL/TAG (STEPHENS) SW/S 18" ELM 59.88 FT. (FOUND WALNUT)
203 DEG. SET NAIL/TAG E/S 16" TREE 72.19 FT.
270 DEG. SET NAIL/TAG S/S 8" ELM 39.46 FT.

RECORDED