

DEC 1 2 1997

COMMISSION

LAND CORNER RECORDATION CERTIFICATE
Filing Requirement of Act 74, Mich. P.A. 1970

Liber 9 Page 174

For corners in

INGHAM
Code # _____
(County)

Located In: Corner
LOCKE TOWNSHIP

FILED

970022433
06/20/1997 15:33:33
REGISTER OF DEEDS
Paula Johnson
INGHAM COUNTY, MI

- 1. Public Land Survey T 4N R 2E F-11
 T _____ R _____
 T _____ R _____
 T _____ R _____
- 2. Property Controlling S _____ T _____ R _____
in Section S _____ T _____ R _____
- 3. Miscellaneous S _____ T _____ R _____
Property in Sec. S _____ T _____ R _____

Register of Deeds Stamp & File Number

- 4. Lot No. _____, Recorded Plat _____
- 5. Private Claims _____

| | A | B | C | D | E | F | G | H | I | J | K | L | M |
|----|----|---|----|---|----|---|----|---|----|---|----|---|---|
| 1 | | | | | | | | | | | | | |
| 2 | 6 | | 5 | | 4 | | 3 | | 2 | | 1 | | |
| 3 | | | | | | | | | | | | | |
| 4 | 7 | | 8 | | 9 | | 10 | | 11 | | 12 | | |
| 5 | | | | | | | | | | | | | |
| 6 | 18 | | 17 | | 16 | | 15 | | 14 | | 13 | | |
| 7 | | | | | | | | | | | | | |
| 8 | 19 | | 20 | | 21 | | 22 | | 23 | | 24 | | |
| 9 | | | | | | | | | | | | | |
| 10 | 30 | | 29 | | 28 | | 27 | | 26 | | 25 | | |
| 11 | | | | | | | | | | | | | |
| 12 | 31 | | 32 | | 33 | | 34 | | 35 | | 36 | | |
| 13 | | | | | | | | | | | | | |

I, RON HELSEL, in a field survey on MARCH 26, 1997 do hereby certify that under requirements of P.A. 74, Michigan P.A. of 1970, the corner points mentioned in lines 1 and 2 above were in conformance with regulations and rules therefore as required in the current manual of survey instructions of the United States Department of the Interior, Bureau of Land Management or by a decree of a Court of Law and /or that the corner points mentioned in lines 3, 4 and 5 above were in conformance with the rules of the Michigan Board of Land Surveyors or by a Decree of a Court of Law; established, re-established, monumented, re-monumented, recovered, found as expressed below:

NOTE: Not more than 4 corners, all in the same town and range, may be recorded on this certificate.

A. Description of original monument and accessories and/or subsequent restoration:
ORIGINAL MONUMENT: POST SET BY JOSEPH WAMPLER, U. S. DEPUTY SURVEYOR, MAR. 1826, MEAN AVERAGE 40.25 CHAINS. LYNWOOD 5", N40E, 18 LINKS; SUGAR, 16", S41E, 23 LINKS.
1) COUNTY SURVEYOR, A. JACKSON, VOL. 2, PAGE 158, AUG. 31, 1853, WITNESSED AS: SUGAR 16", S31E, 23 LINKS (10 DEG. DIFFERENT)
MAPLE 9", N53W, 18 3/4 LINKS

2) INGHAM COUNTY ROAD COM. GRID MAP WITNESSED THIS CORNER AS A STONE:
P.P. EAST, 43.5' (FOUND)
ANCH. POST, WEST, 30.83' (GONE)
T.P., SSE, 45.53' (GONE)

3) L.C.R.C. RECORDED IN LIBER 3, PAGE 544, DATED 12-12-1975, BY DOUGLAS HOOTH NO. 7966; "MDSH & T SURVEY IN 1940, SURVEY RECORDS OF STATE PROJ. 33-51. POINTED BOULDER 10.50' EAST OF HWY. E." 1940 WITNESSES SAME AS (3-A) ABOVE. "PLACED 5/8" REBAR IN MON. BOX OVER STONE." CHIS. X IN N. END OF CULV. N40E, 25.83' (FOUND)
CHIS. X IN S. END OF CULV. S75E, 18.36' (FOUND) SIGN POST N80W, 70.00' (GONE) P.POLE (OLD TAG IN FACE) EAST, 43.42' (FOUND)


(CONTINUED ON BACK)

B. Description of corner evidence found and/or method applied in restoring or reestablishing corner:

EXCAVATED AND FOUND MUSHROOMED 5/8" REBAR ON THE SOUTH SIDE OF A POINTED STONE. FOUND A STRONG READING IN THE POSITION OF THE BOAT SPIKE IN THE E. OF M-52, 10.5 FEET WEST. ACCEPTED THE REBAR AS FAITHFUL PERPETUATION OF THE 1940 MDSH CORNER AND PLACED A CAP STAMPED P. A. 345, P.S. NO. 18994. RAISED MON. BOX TO SURFACE OF PAVEMENT.

C. Description of monument for corner and accessories established to perpetuate locating the position of the corner:
5/8" REBAR AND CAP 10.5 FEET EAST OF THE E. OF M-52

SET NAIL AND TAG NO. 18994 EAST/SIDE 30' MAPLE, AZ., 184 DEG., 400.33 FEET
SET NAIL AND TAG NO. 18994 WEST/SIDE POWER POLE, AZ., 167 DEG., 284.08 FEET
SET NAIL AND TAG NO. 18994 WEST/SIDE POWER POLE, AZ., 43 DEG., 303.43 FEET
FOUND CHISELED X NORTH END OF CONCRETE CULVERT, AZ., 39 DEG., 25.83 FEET
FOUND CHISELED X SOUTH END OF CONCRETE CULVERT, AZ., 101 DEG., 18.45 FEET
SET NAIL AND TAG NO. 18994 NORTH/ SIDE POWER POLE, AZ., 88 DEG., 43.73 FEET

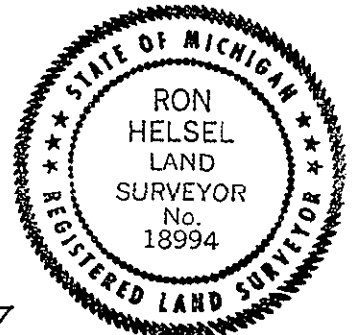

Signed by Ron Helsel Date 6-7-97
Surveyor's Michigan License No. 18994

