

REMONUMENTATION

DEC 12 1997

LAND CORNER RECORDATION CERTIFICATE
Filing Requirement of Act 74, Mich. P.A. 1970

Liber


9 Page 170

For corners in COMMISSION

INGHAM
Code #
(County)

Located In: Corner
LOCKE TOWNSHIP

- 1. Public Land Survey T. 4N R. 2E G-11
T. R.
T. R.
T. R.
- 2. Property Controlling in Section S. T. R.
S. T. R.
- 3. Miscellaneous Property in Sec. S. T. R.
S. T. R.

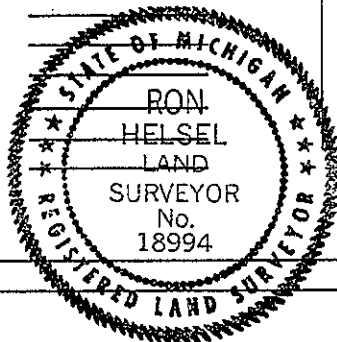

FILED

970022429
06/20/1997 15:33:27
REGISTER OF DEEDS
Paula Johnson
INGHAM COUNTY, MI

Register of Deeds Stamp & File Number

- 4. Lot No. _____, Recorded Plat _____
- 5. Private Claims _____

	A	B	C	D	E	F	G	H	I	J	K	L	M
1													
2		6		5		4		3		2		1	
3													
4		7		8		9		10		11		12	
5													
6		18		17		16		15		14		13	
7													
8		19		20		21		22		23		24	
9													
10		30		29		28		27		26		25	
11													
12		31		32		33		34		35		36	
13													

I, RON HELSEL, in a field survey on APRIL 3, 1997 do hereby certify that under requirements of P.A. 74, Michigan P.A. of 1970, the corner points mentioned in lines 1 and 2 above were in conformance with regulations and rules therefore as required in the current manual of survey instructions of the United States Department of the Interior, Bureau of Land Management or by a decree of a Court of Law and for that the corner points mentioned in lines 3, 4 and 5 above were in conformance with the rules of the Michigan Board of Land Surveyors or by a Decree of a Court of Law; established, re-established, monumented, re-monumented, recovered, found as expressed below:

NOTE: Not more than 4 corners, all in the same town and range, may be recorded on this certificate.

A. Description of original monument and accessories and/or subsequent restoration:
ORIGINAL MONUMENT: POST SET BY JOSEPH WAMPLER, U. S. DEPUTY SURVEYOR, MAR., 1826, BEECH, 8", SAW, 25 LINKS
SUGAR, 20" N38E, 40 LINKS
1) COUNTY SURVEYOR, A. JACKSON, VOL. 2, PAGE 158, AUG. 31, 1853, WITNESSED THIS CORNER THE SAME AS THE ORIGINAL.
DID NOT FIND FURTHER MENTION OF THIS CORNER IN ANY PUBLIC OR PRIVATE RECORDS.

B. Description of corner evidence found and/or method applied in restoring or reestablishing corner:
ORIGINALLY SEARCHED FOR THIS CORNER IN OCTOBER OF 1996 AND DEEMED IT A LOST CORNER AT THAT TIME. TRAVERSED IN THE FOUR CARDINAL DIRECTIONS IN AN ATTEMPT TO SET THE CORNER BY DOUBLE PROPORTIONAL MEASUREMENT. FINAL COMPUTATIONS LOCATED THE POINT 12 FEET MORE OR LESS INTO A PLOWED FIELD. AZIMUTH TO F-11 HIT A LONE 40" MAPLE WITH FENCE GROWN IN THE NORTHERLY 1/3 OF THE TRUNK. SEARCHED THE AREA AGAIN AND FOUND A WAVY SHAPED STONE 12" X 4" X 8" OVER TOP OF A WEAK MAGNETIC READING. EXCAVATED DOWN THROUGH STONES AND SHARDS OF OLD FENCE AND FOUND A VERY OLD PLOW POINT 18" TO 22" DEEP NEXT TO A 15" DIAMETER STONE. LOCATION OF THE PLOW POINT WAS ON LINE WITH THE MENTIONED MAPLE AND THE NORTH 1/4 CORNER OF SECTION 33, WITHIN 1.36 FEET OF BEING EQUIDISTANT BETWEEN THE 1/4 CORNERS TO THE NORTH AND SOUTH AND WAS WITHIN A FOOT MORE OR LESS OF BEING DOUBLE THE DISTANCE OF AN UNRECORDED SURVEY JOB 79-B-081, DATED 8-03-79, FROM THE SOUTH 1/4 CORNER OF SECTION 27 TO THE SE CORNER OF 27 BY L. BRYAN, P.S. 25832. THE POSITION ALSO WAS IN A GRASSY AREA BETWEEN PLOWED FIELDS AND WAS MORE OR LESS ON LINE WITH A TREE AND BRUSH ROW STARTING ABOUT 300 FEET TO THE NORTH. ACCEPTED THE POSITION OF THE PLOW POINT AS A MARKER FOR THE CORNER AND RAISED IT TO GRADE AND SET A 3/4" X 24" FORM PIN AND CAP STAMPED P.A. 345, P.S. NO. 18994.

C. Description of monument for corner and accessories established to perpetuate locating the position of the corner:
3/4" FORM PIN ON WEST SIDE OF OLD PLOW POINT IN GRASSY AREA BETWEEN PLOWED FIELDS 325' NORTH OF & OF SULLIVAN CREEK.
SET NAIL AND TAG NO. 18994 WEST/SIDE, 10" POPLAR, AZ., 195 DEG., 323.73 FEET
SET NAIL AND TAG NO. 18994 WEST/SIDE, 10" ELM, AZ., 173 DEG., 310.86 FEET
SET NAIL AND TAG NO. 18994 SOUTH/SIDE TRIPLE 4" ASH, AZ., 111 DEG., 252.99 FEET
SET NAIL AND TAG NO. 18994 WEST/SIDE 1 1/2" TWIN OAK, AZ., 150 DEG., 64.32 FEET
G-11 TO G-10 MEA. 2633.09 FEET
G-11 TO G-12 MEA. 2630.35 FEET
G-11 TO H-11 MEA. 2677.53 FEET GLO 40.45 CHAINS (2669.7') (BRYAN DATUM H-11 TO I-11 MEA. 2676.31 FEET)
G-11 TO F-11 MEA. 2693.98 FEET GLO 40.25 CHAINS (2656.5')

Signed by Ron Helsel Date 6-7-97
Surveyor's Michigan License No. 18994