

DEC 16 1996

COMMISSION

LAND CORNER RECORDATION CERTIFICATE  
Filing Requirement of Act 74, Mich. P.A. 1970  
LOCKE TOWNSHIP

Liber 9 Page 61


For corners in

INGHAM  
(County)

Located In:

Corner Code #

- 1. Public Land Survey T 4N R 2E
- T \_\_\_\_\_ R \_\_\_\_\_
- T \_\_\_\_\_ R \_\_\_\_\_
- T \_\_\_\_\_ R \_\_\_\_\_
- 2. Property Controlling S \_\_\_\_\_ T \_\_\_\_\_ R \_\_\_\_\_
- in Section S \_\_\_\_\_ T \_\_\_\_\_ R \_\_\_\_\_
- 3. Miscellaneous S \_\_\_\_\_ T \_\_\_\_\_ R \_\_\_\_\_
- Property in Sec. S \_\_\_\_\_ T \_\_\_\_\_ R \_\_\_\_\_

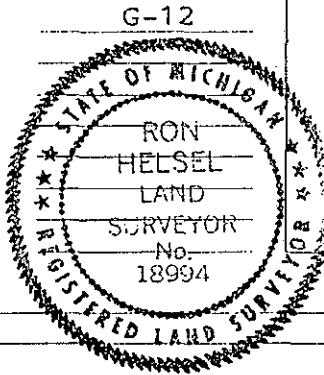

FILED

960043088  
11/08/1996 14:28:54  
REGISTER OF DEEDS  
Paula Johnson  
INGHAM COUNTY, MI

Register of Deeds Stamp & File Number

- 4. Lot No. \_\_\_\_\_, Recorded Plat \_\_\_\_\_
- 5. Private Claims \_\_\_\_\_

	A	B	C	D	E	F	G	H	I	J	K	L	M
2	6	5	4	3	2	1							
3													
4	7	8	9	10	11	12							
5													
6	18	17	16	15	14	13							
7													
8	19	20	21	22	23	24							
9													
10	30	29	28	27	26	25							
11													
12	31	32	33	34	35	36							
13													

I, RON HELSEL, in a field survey on OCTOBER 1, 19 96, do hereby certify that under requirements of P.A. 74, Michigan P.A. of 1970, the corner points mentioned in lines 1 and 2 above were in conformance with regulations and rules therefore as required in the current manual of survey instructions of the United States Department of the Interior, Bureau of Land Management or by a decree of a Court of Law and/or that the corner points mentioned in lines 3, 4 and 5 above were in conformance with the rules of the Michigan Board of Land Surveyors or by a Decree of a Court of Law; established, re-established, monumented, re-monumented, recovered, found as expressed below:

NOTE: Not more than 4 corners, all in the same town and range, may be recorded on this certificate.

A. Description of original monument and accessories and/or subsequent restoration:

ORIGINAL MONUMENT: POST SET BY J. WAMPLER, U.S. DEPUTY SURVEYOR  
40 CHAINS FROM G-13  
BEECH 13" S14 1/2W, 7 LINKS  
ASH 8" N46E, 38 1/2 LINKS

- 1) VOL. 2, Pg. 158, COUNTY SURVEYOR A. JACKSON, AUG. 31, 1853 CITED ORIGINAL BEARING TREES.
- 2) VOL. 2, PG. 180, COUNTY SURVEYOR A. JACKSON, FEB. 1, 1854 CITED ORIGINAL BEARING TREES.
- 3) VOL. 2, PG. 182, COUNTY SURVEYOR A. JACKSON, FEB. 2, 1854 CITED ORIGINAL BEARING TREES.

B. Description of corner evidence found and/or method applied in restoring or reestablishing corner:

FOUND 1/2" BAR & CAP ON NORTH SIDE OF STONE IN CENTERLINE OF ROWLEY ROAD. EXCAVATED AND FOUND OBELISK SHAPED STONE WITH TOP BROKEN OFF 4" SQUARE AT TOP, 12" SQUARE AT BOTTOM & 28" LONG SURROUNDED WITH BRICKS. RAISED GRADE OF STONE AND SET 3/4" X 24" FORM PIN ON NORTH SIDE OF STONE IN MONUMENT BOX. ACCEPTED THE POSITION OF THE STONE AS FAITHFUL PERPETUATION OF AN UNRECORDED COUNTY SURVEYOR MONUMENT.

C. Description of monument for corner and accessories established to perpetuate locating the position of the corner:

3/4" X 24" FORM PIN AND CAP LABELED P.A. 345, P.S. NO. 18994  
SET NAIL AND TAG NO. 18994, W/SIDE 24" MAPLE, AZ. 182°, 24.42'  
SET NAIL AND TAG NO. 18994, N/SIDE 50" MAPLE, AZ. 266°, 148.47'  
SET 1/2" BAR & CAP NO. 18994 AT NORTH END OF 8" CONC. HEADWALL, AZ. 09°, 19.68'  
SET 1/2" BAR & CAP NO. 18994 AT NORTH END OF 8" CONC. HEADWALL, AZ. 50°, 27.36'

Signed by

*Ron Helsel*

Date

Oct. 4, 1996

Surveyor's Michigan License No.

18994

P.A. 345 INGHAM COUNTY

PEER APPROVED

10/17/96 *M*

## "A" CONTINUED

- 4) A SURVEY WAS RECORDED IN LIBER 2, PG. 479 ALONG WITH A L.C.R.C. IN LIBER PG. 436, DATED MAY 5, 1975 BY RON HELSEL P.S. NO. 18994. "EXCAVATED AND FOUND ROCK WITH "X" OVER A PINCH PIPE 18" BELOW BIT. PAVEMENT. SET 1/2" IRON BAR & CAP TO GRADE."  
SOUTH, 30.82' NORTH FACE OF 4" STEEL ANCHOR POST (FOUND)  
S45°E, 47.70' N & T 30" MAPLE (FOUND ROOTS)  
S45°W, 39.79' N & T 30" MAPLE (GONE)
- 5) SURVEYS WERE RECORDED IN LIBER 2, PGS. 1206-1208, MAY 31, 1977, LIBER 3, PGS. 687-690, SEPT. 6, 1978 BY G. BOSS P.S. NO. 17022. "FD. 1/2" BAR & CAP OVER ROCK" SAME WITNESSES 4-A ABOVE AND (2) ADDITIONAL. NAIL SET NW/S 24" MAPLE, S75°W, 73.07' (GONE)  
NAIL SET W/S 24" MAPLE, DUE S. 24.79' (FOUND TREE)
- 6) SURVEYS WERE RECORDED IN LIBER 4, PAGE 862, APRIL 27, 1984, LIBER 4, PAGE 973, AUG. 15, 1984, LIBER 4, PAGE 977, SEPT. 10, 1984, AND LIBER 5, PAGE 1, MARCH 7, 1986 BY F.N. WHITE NO. 12034. ALL CITED L.C.R.C. LIBER 3, PAGE 436 AND NO WITNESSES.

FILED