

DEC 12 1997

COMMISSION

LAND CORNER RECORDATION CERTIFICATE  
Filing Requirement of Act 74, Mich. P.A. 1970

Liber

9 Page 171

FILED

970022430  
06/20/1997 15:33:29  
REGISTER OF DEEDS  
Paula Johnson  
INGHAM COUNTY, MI

For corners in

INGHAM Located In: \_\_\_\_\_ Corner  
Code # \_\_\_\_\_  
(County) LOCKE TOWNSHIP

- 1. Public Land Survey T 4N R 2E \_\_\_\_\_ G-13  
T \_\_\_\_\_ R \_\_\_\_\_  
T \_\_\_\_\_ R \_\_\_\_\_  
T \_\_\_\_\_ R \_\_\_\_\_
- 2. Property Controlling S \_\_\_\_\_ T \_\_\_\_\_ R \_\_\_\_\_  
in Section S \_\_\_\_\_ T \_\_\_\_\_ R \_\_\_\_\_
- 3. Miscellaneous S \_\_\_\_\_ T \_\_\_\_\_ R \_\_\_\_\_  
Property in Sec. S \_\_\_\_\_ T \_\_\_\_\_ R \_\_\_\_\_

Register of Deeds Stamp & File Number

- 4. Lot No. \_\_\_\_\_, Recorded Plat \_\_\_\_\_
- 5. Private Claims \_\_\_\_\_

I, RON HELSEL, in a field survey on APRIL 10, 1997 do hereby certify that under requirements of P.A. 74, Michigan P.A. of 1970, the corner points mentioned in lines 1 and 2 above were in conformance with regulations and rules therefore as required in the current manual of survey instructions of the United States Department of the Interior, Bureau of Land Management or by a decree of a Court of Law and /or that the corner points mentioned in lines 3, 4 and 5 above were in conformance with the rules of the Michigan Board of Land Surveyors or by a Decree of a Court of Law; established, re-established, monumented, re-monumented, recovered, found as expressed below:

A	B	C	D	E	F	G	H	I	J	K	L	M
1												
2	6		5		4		3		2		1	
3												
4	7		8		9		10		11		12	
5												
6	18		17		16		15		14		13	
7												
8	19		20		21		22		23		24	
9												
10	30		29		28		27		26		25	
11												
12	31		32		33		34		35		36	
13												


NOTE: Not more that 4 corners, all in the same town and range, may be recorded on this certificate.

A. Description of original monument and accessories and/or subsequent restoration:  
ORIGINAL MONUMENT: POST SET BY JOSEPH WAMPLER, U. S. DEPUTY SURVEYOR, MAR. 1826. BEECH, 6", N72 1/2W, 16 LINKS  
BEECH, 10", N78E, 34 LINKS

- 1) VOL. 2, PAGE 180, COUNTY SURVEYOR, A. JACKSON WITNESSED SAME AS ABOVE, FEB. 1, 1854.
- 2) VOL. 2, PAGE 182, COUNTY SURVEYOR, A. JACKSON WITNESSED SAME AS ABOVE, FEB. 2, 1854.
- 3) SURVEYS FROM FOLDER 1, PAGES 54 AND 55 (CETA DATUM 1978) ARE THE SAME AS 1-A AND 2-A ABOVE.
- 4) A SURVEY BY G. BOSS NO. 17022, DATED 9-6-1979, RECORDED IN LIBER 3, PAGES 687-690 AND A L.C.R.C BY SAME DATED 9-11-79 AND RECORDED IN LIBER 5, PAGE 11, "1/2" REROD SET 6.60' (10 LINKS) WEST OF NE COR. OF SEC. 4 T3N-R2E ALONG EAST-WEST FENCE LINE PER GOVERNMENT NOTES." N10E, N. W/S 10" ASH 36.98' (FOUND TREE); EAST 4" STEEL POST 6.60'; WEST N. N/S 10" OAK 38.73' (FOUND TREE); S15W N. E/S 4" MAPLE 10.71' (FOUND TREE).  
DID NOT FIND FURTHER MENTION OF THIS CORNER.

B. Description of corner evidence found and/or method applied in restoring or reestablishing corner:  
FOUND 1/2" REBAR AND CAP AS SET BY SURVEYOR BOSS AT BASE OF AND SOUTH SIDE OF AN 1 1/2" STEEL ANCHOR POST BRACE AND ALL THREE BEARING TREES ALONG WITH THE 4" STEEL ANCHOR POST WITH FENCES TO THE SOUTH, NORTH AND WEST. (POST RECORDED IN LIBER 8, PAGES 354-355 AS G-1 OF LEROY TOWNSHIP AND PEER APPROVED 11-09-94.) \* EXCAVATED A 3'X3' HOLE TO A DEPTH OF 2 FEET MORE OR LESS AND DID NOT FIND ANY EVIDENCE OF A PREVIOUS CORNER MARKER. ACCEPTED THE POSITION OF THE BOSS MARKER AS FAITHFUL PERPETUATION OF THE CORNER AND REPLACED THE BAR WITH A 3/4" X 24" FORM PIN AND CAP STAMPED P.A. 345, P.S. NO. 18994.  
G. BOSS REC. DISTANCE TO F-13, 2635.04 FEET  
G. BOSS REC. DISTANCE TO G-12, 2627.47 FEET

C. Description of monument for corner and accessories established to perpetuate locating the position of the corner:  
3/4" FORM PIN AND CAP 6.60 FEET WEST OF CLOSING CORNER LEROY TOWNSHIP.  
FOUND NAIL AND TAG NO. 25832, (P.S. L. BRYAN) WEST/SIDE 18" ASH, AZ., 18 DEG., 36.82 FEET  
FOUND NAIL AND TAG NO. 25832, NORTH/SIDE 18" OAK, AZ., 280 DEG., 38.89 FEET  
FOUND NAIL AND TAG NO. 25832, NORTH/SIDE 20" OAK, AZ., 172 DEG., 34.28 FEET  
SET NAIL AND TAG NO. 18994, WEST/SIDE 8" ASH, AZ., 44 DEG., 9.17 FEET  
EAST, 6.60 FEET TO C. OF 4" STEEL ANCHOR POST. ( G-1 LEROY TOWNSHIP)

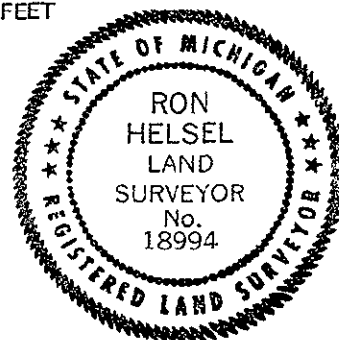

Signed by Ron Helsel Date 6-7-97  
Surveyor's Michigan License No. 18994