

REMONUMENT STATE

DEC 1 2 1997

COMMISSION

LAND CORNER RECORDATION CERTIFICATE  
Filing Requirement of Act 74, Mich. P.A. 1970

Liber 9 Page 173

FILED

970022432  
06/20/1997 15:33:32  
REGISTER OF DEEDS  
Paula Johnson  
INGHAM COUNTY, MI

For corners in

INGHAM  
Code #  
(County)

Located in: Corner  
LOCKE TOWNSHIP

- 1. Public Land Survey T 4N R 2E H-13  
T      R       
T      R       
T      R
- 2. Property Controlling in Section S      T      R       
S      T      R
- 3. Miscellaneous Property in Sec. S      T      R       
S      T      R

Register of Deeds Stamp & File Number

- 4. Lot No. \_\_\_\_\_, Recorded Plat \_\_\_\_\_
- 5. Private Claims \_\_\_\_\_

I, RON HELSEL, in a field survey on APRIL 10, 1997 do hereby certify that under requirements of P.A. 74, Michigan P.A. of 1970, the corner points mentioned in lines 1 and 2 above were in conformance with regulations and rules therefore as required in the current manual of survey instructions of the United States Department of the Interior, Bureau of Land Management or by a decree of a Court of Law and for that the corner points mentioned in lines 3, 4 and 5 above were in conformance with the rules of the Michigan Board of Land Surveyors or by a Decree of a Court of Law; established, re-established, monumented, re-monumented, recovered, found as expressed below:

NOTE: Not more than 4 corners, all in the same town and range, may be recorded on this certificate.

A. Description of original monument and accessories and/or subsequent restoration:  
ORIGINAL MONUMENT: POST SET BY JOSEPH WAMPLER, U. S. DEPUTY SURVEYOR, MAR., 1826. SUGAR, 18", N70E, 10 LINKS  
MAPLE, 13", N36W, 50 LINKS

1) COUNTY SURVEYOR, A. JACKSON, VOL. 2, PAGE 182, FEB. 2, 1854, WITNESSED THE CORNER SAME AS ORIGINAL.


2) L.C.R.C. BY R. LESTER NO. 18998, DATED MAY 7, 1981, LIBER 6, PAGE 201 UNDER INGHAM COUNTY CETA PROGRAM. "FIELD INSPECTION REVEALED 6" IRON FENCE POST SET IN CONCRETE WITH FENCE NORTH EAST AND WEST. DISTANCE MEASURED NORTH, WEST, AND EAST ARE IN CLOSE ACCORD WITH GLO MEASUREMENTS. ACCEPTED 6" IRON FENCE POST AS PERPETUATED LOCATION OF H-13. MEASURED NORTH 2626.23' TO H-12, MEASURED EAST 2657.53' TO I-13, MEASURED WEST 2651.55' TO G-13." WITNESSED AS: NAIL AND TAG, #18998, EAST SIDE 20" BEECH, N20W, 19.06' NAIL AND TAG, # 18998, EAST SIDE POWER POLE, SOUTH, 6.71' NAIL AND TAG, # 18998, EAST SIDE 30" BEECH, S15E, 35.92' NAIL AND TAG, # 18998, WEST SIDE 44" MAPLE, S10W, 26.00' 4" CONCRETE MONUMENT AT H-1, LEROY, EAST, 6.30'

B. Description of corner evidence found and/or method applied in restoring or reestablishing corner:

FOUND 4" STEEL ANCHOR POST AT LOCATION OF CITED 6" POST WITH FENCES TO NORTH, WEST AND EAST. FOUND ALL 4 BEARING TREES AND CONCRETE MONUMENT AT LOCATION OF THE LEROY TWP. CORNER. THE REFERENCE IN THE L.C.R.C ABOVE OF A DISTANCE OF 2657.53' FROM H-13 TO I-13 APPEARS TO HAVE BEEN FROM H-13 TO I-1 OF LEROY TOWNSHIP. COMPUTATIONS OF A M. FOUTY SURVEY, NO. 18989 ALONG THE NORTH LINE OF SECTION 3. HIS MEASUREMENT IS 2650.67' BETWEEN H-1 AND I-1, ADDING 6.60 FEET FOR THE TWP. JOG IS 2657.27' (IN ACCORD WITH THE LESTER MEASUREMENT). ACCEPTED THIS POSITION AS A PERPETUATED MARKER FOR THE CORNER AND SET A 3/4" X 24" FORM PIN AND CAP STAMPED P.A. 345, P.S. NO. 18994 IN CENTER OF 4" BASE OF REMAINING STEEL POST. THE TOP 4 FEET OF THE POST HAS RUSTED AND SEPARATED FROM THE CONCRETE BASE.

C. Description of monument for corner and accessories established to perpetuate locating the position of the corner:

3/4" FORM PIN AND CAP IN & OF 4" STEEL POST AT GROUND LEVEL  
EAST, 6.15 FEET 4' CONCRETE MONUMENT AT H-1 LEROY TOWNSHIP  
FOUND NAIL AND TAG NO. 25832, EAST/SIDE 30" BEECH, AZ., 335 DEG., 18.56 FEET  
FOUND NAIL AND TAG NO. 25832, EAST/SIDE 20" BEECH, AZ., 175 DEG., 35.85 FEET  
FOUND NAIL AND TAG NO. 18998, WEST/SIDE 40" HARD MAPLE, AZ., 190 DEG., 26.00 FEET  
SET NAIL AND TAG NO. 18994, WEST/SIDE POWER POLE, AZ., 174 DEG., 6.21 FEET

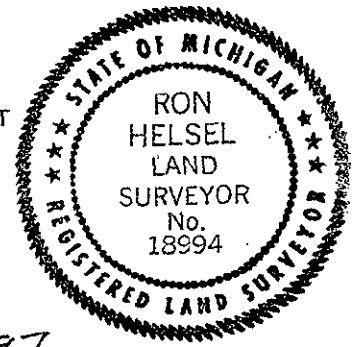

Signed by Ron Helsel

Date 6-7-97

Surveyor's Michigan License No. 18994