

DEC 18 1996

COMMISSION

LAND CORNER RECORDATION CERTIFICATE  
Filing Requirement of Act 74, Mich. P.A. 1970

Liber 9 Page 70

For corners in

INGHAM  
Code #  
(County)

Located In: Corner  
LOCKE TOWNSHIP

- 1. Public Land Survey T 4N R 2E 1-12  
T \_\_\_\_\_ R \_\_\_\_\_  
T \_\_\_\_\_ R \_\_\_\_\_  
T \_\_\_\_\_ R \_\_\_\_\_
- 2. Property Controlling S \_\_\_\_\_ T \_\_\_\_\_ R \_\_\_\_\_  
in Section S \_\_\_\_\_ T \_\_\_\_\_ R \_\_\_\_\_
- 3. Miscellaneous S \_\_\_\_\_ T \_\_\_\_\_ R \_\_\_\_\_  
Property in Sec. S \_\_\_\_\_ T \_\_\_\_\_ R \_\_\_\_\_

**FILED**  
960044041  
11/18/1996 13:01:17  
REGISTER OF DEEDS  
Paula Johnson  
INGHAM COUNTY, MI

Register of Deeds Stamp & File Number

4. Lot No. \_\_\_\_\_, Recorded Plat \_\_\_\_\_  
5. Private Claims \_\_\_\_\_

I, RON HELSEL, in a field survey on OCTOBER 31  
OCTOBER 15, 1996  
do hereby certify that under requirements of P.A. 74, Michigan P.A. of 1970, the corner points mentioned in lines 1 and 2 above were in conformance with regulations and rules therefore as required in the current manual of survey instructions of the United States Department of the Interior, Bureau of Land Management or by a decree of a Court of Law and /or that the corner points mentioned in lines 3, 4 and 5 above were in conformance with the rules of the Michigan Board of Land Surveyors or by a Decree of a Court of Law; established, re-established, monumented, re-monumented, recovered, found as expressed below:

NOTE: Not more that 4 corners, all in the same town and range, may be recorded on this certificate.


- A. Description of original monument and accessories and/or subsequent restoration:  
ORIGINAL MONUMENT: POST SET BY J. WAMPLER, U.S. DEPUTY SURVEYOR  
ASH 30 N88W, 13 LINKS  
BEECH 9 N42E, 33 LINKS  
1) VOL. 2, PAGE 276, COUNTY SURVEYOR A. JACKSON, FEB. 27, 1856, CITED THE ORIGINAL BEARING TREES.  
2) VOL. 3, PAGE 159, COUNTY SURVEYOR A. P. DRAKE CALLED FOR A STONE BURR OAK 3, N881/2E, 106 1/2 LINKS, DEC. 2, 1879.

	A	B	C	D	E	F	G	H	I	J	K	L	
1													
2	6			5			4			3		2	1
3													
4	7			8			9			10		11	12
5													
6	18			17			16			15		14	13
7													
8	19			20			21			22		23	24
9													
10	30			29			28			27		26	25
11													
12	31			32			33			34		35	36
13													

CONTINUED ON BACK

B. Description of corner evidence found and/or method applied in restoring or reestablishing corner:  
FOUND 1/2" REBAR AND ILLEGIBLE CAP AT CENTERLINE WEBBERVILLE ROAD, AND ROWLEY ROAD EXTENDED FROM WEST. EXCAVATED 3' BY 5' HOLE, 3' DEEP INTO CLAY ROAD BED. AT 2.0 FEET DEEP FOUND A 4" BY 12" BY 28" BLUE STONE IN AN UPRIGHT POSITION IN A CIRCLE OF SMALL STONES AND IN YELLOW SANDY SOIL IN THE GREY CLAY ROAD BED. ACCEPTED THE POSTION OF THE 1/2" REBAR AS FAITHFUL PERPETUATION OF THE CORNER ALONG WITH THE BLUE STONE AS SUPPORTING EVIDENCE. SET A 3/4" BY 24" STEEL FORM PIN WITH A CAP LABELED P. A. 345 P.S. NO. 18994 IN MONUMENT BOX. STONE LOCATED 0.85 FEET EAST OF THE FORM PIN.

C. Description of monument for corner and accessories established to perpetuate locating the position of the corner:  
3/4" BY 24" STEEL FORM PIN IN CENTERLINE OF WEBBERVILLE ROAD AND ON CENTERLINE OF ROWLEY ROAD EXTENDED FROM THE WEST.  
SET NAIL AND TAG NO. 18994 S/SIDE 7' HICKORY, AZ. 86°, 21.30 FEET  
SET NAIL AND TAG NO. 18994 SE/SIDE POWER POLE, AZ. 235°, 103.86 FEET  
SET NAIL AND TAG NO. 18994 NE/SIDE 10" ASH, AZ. 163°, 123.13 FEET  
SET NAIL AND TAG NO. 18994 N/SIDE 26" HICKORY, AZ. 261°, 218.87 FEET  
SET NAIL AND TAG NO. 18994 W/SIDE 12" PINE, AZ. 15°, 98.07 FEET  
FOUND NAIL AND TAG NO. 13574 W/SIDE GUY POLE, AZ. 160°, 64.47 FEET

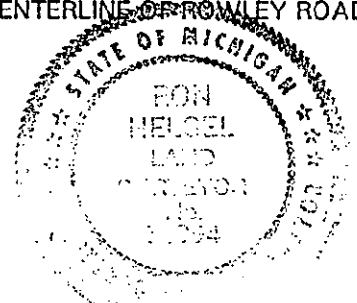

Signed by Ron Helsel Date NOV. 2, 1996  
Surveyor's Michigan License No. 18994

