

**SURVEY & REMONUMENTATION**

**JAN 18 2001**

Paula Johnson  
INGHAM COUNTY  
REGISTER OF DEEDS  
RON HELSEL

**L-10 P-4**

CRNR 9.00

2000-044598

2000-044598

Page: 1 of 1  
10/18/2000 11:02A



**SECTION**

**LAND CORNER RECORDATION CERTIFICATE**  
Filing Requirement of Act 74, Mich. P.A. 1970

LOCKE TOWNSHIP

For corners in

<u>INGHAM</u> <small>(County)</small>	Located In:	Corner Code #
1. Public Land Survey	T <u>4N</u> R <u>2E</u>	<u>J-13</u>
	T _____ R _____	_____
	T _____ R _____	_____
	T _____ R _____	_____
2. Property Controlling in Section	S _____ T _____ R _____	_____
	S _____ T _____ R _____	_____
3. Miscellaneous Property in Sec.	S _____ T _____ R _____	_____
	S _____ T _____ R _____	_____
4. Lot No. _____, Recorded Plat _____		
5. Private Claims _____		

Register of Deeds Stamp & File Number

I, RON HELSEL, in a field survey on SEPT. 19, 2000 do hereby state that under requirements of P.A. 74, Michigan P.A. of 1970, the corner points mentioned in lines 1 and 2 above were in conformance with regulations and rules therefore as required in the current manual of survey instructions of the United States Department of the Interior, Bureau of Land Management or by a decree of a Court of Law and /or that the corner points mentioned in lines 3, 4 and 5 above were in conformance with the rules of the Michigan Board of Land Surveyors or by a Decree of a Court of Law; established, re-established, monumented, recovered, found as expressed below:


NOTE: Not more than 2 corners, all in the same town and range, may be recorded on this certificate.

- A. Description of original monument and accessories and/or subsequent restoration:  
ORIGINAL MONUMENT: POST SET BY J. WAMPLER, U.S. DEPUTY SURVEYOR, APRIL, 1826. 40 CHAINS WEST OF K-13. MAPLE 3", N48-1/2W, 18 LINKS; MAPLE 4", N34E, 21-1/2 LINKS (14.19')
- VOL. 2, PAGE 181, NOV. 18 & DEC. 2, 1879, A.D. DRAKE, CO. SURVEYOR STONE, W.O. 2-1/2", S70E, 35-1/2 LINKS.
  - P.A. 74 CORNER, LIBER 2, PAGE 55, AUG. 28, 1972, OSCAR BOSS, P.S. 13574. "P.K. NAIL SET - SECTION SUBDIVISION" N35E, 12.25' NAIL WEST SIDE 54" OAK; N65W, 100.11' NAIL SOUTH SIDE 24" MAPLE; S70W, 58.4' NAIL NORTH SIDE 20" MAPLE.
  - P.A. 132 SURVEYS WERE RECORDED IN LIBER 1, PAGE 403, 5-22-72; LIBER 1, PAGES 563-564, OCT. 7, 72 AND IN LIBER 1, PAGES 1006-1008, MAR. 6, 1973 BY O. BOSS. ALL THREE GAVE THE SAME WITNESSES AS 2-A ABOVE.
  - INGHAM CO. CETA PROGRAM EXCAVATED A 27.6' BY 10' HOLE AROUND A FOUND O. BOSS BAR AND CAP FOUND AT THIS LOCATION. A STONE WAS FOUND 3.3 SOUTH OF THE IRON BAR ON OCT. 23, 1978. NO SUBSEQUENT CORNER WAS SET.

B. Description of corner evidence found and/or method applied in restoring or reestablishing corner:  
FOUND A 1/2" REBAR AT THE LOCATION RECORDED BY O. BOSS IN 2-A ABOVE GOT A READING AT 58.4 FEET IN BARK OF OVERGROWN NAIL ON THE NORTH SIDE OF QUAD MAPLE, WHICH I BELIEVE SURVEYOR BOSS CALLED A 20" MAPLE. EXCAVATED THE STONE IDENTIFIED BY THE CETA CREW IN 4-A ABOVE AND DEEMED IT NOT A CORNER MARKER SET BY A COUNTY SURVEYOR. ACCEPTED THE POSITION OF THE BAR AS FAITHFUL PERPETUATION OF THE CORNER AFTER A TRAVERSE DETERMINED THE BAR TO BE WITHIN 0.25 FEET OF THE MIDPOINT BETWEEN K-13 AND I-13. REPLACED BAR WITH 3/4" BY 24" PIN AND INGHAM COUNTY DISK STAMPED P.A. 345, P.S. 18994.

C. Description of monument for corner and accessories established to perpetuate locating the position of the corner:  
3/4" BY 24" IRON PIN AND DISK 1.5 FEET NORTH OF THE C/L OF ALLEN ROAD.  
SET NAIL & TAG #18994 NORTH/SIDE 12' QUAD. MAPLE, N. AZ. 118°, 85.23 FEET  
SET NAIL & TAG #18994 SOUTH/SIDE 18" TWIN MAPLE, N. AZ. 86°, 124.57 FEET  
FOUND NAIL & TAG #18989, WEST/SIDE 36" OAK, N. AZ. 42°, 39.90 FEET  
FOUND NAIL & TAG #19834, SOUTH/SIDE 12" QUAD MAPLE, N. AZ. 259°, 58.69 FEET  
EAST, 9.85 FEET TO J-1, T3N, R2E (LEROY TWP.)  
MEAS. WEST 2648.26 FEET TO I-13  
MEAS. EAST 2648.81 FEET TO K-13

A	B	C	D	E	F	G	H	I	J	K	L	M
1												
2	6		5		4		3		2		1	
3												
4	7		8		9		10		11		12	
5												
6	18		17		16		15		14		13	
7												
8	19		20		21		22		23		24	
9												
10	30		29		28		27		26		25	
11												
12	31		32		33		34		35		36	
13												

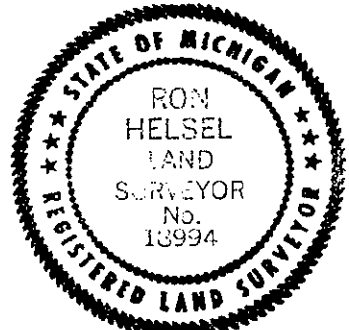

Signed by Ron Helsel  
Surveyor's Michigan License No. 18994

Date Oct. 7 00

P.A. 345 INGHAM COUNTY  
PEER APPROVED 10/3/2000 ML