

DEC 17 1998

SECTION

LAND CORNER RECORDATION CERTIFICATE
Filing Requirement of Act 74, Mich. P.A. 1970

Liber 9 Page 398

For corners in

<u>INGHAM</u>	Located In:	Corner Code #
(County)	LOCKE TOWNSHIP	
1. Public Land Survey	T <u>4N</u> R <u>2E</u>	<u>K-13</u>
	T _____ R _____	_____
	T _____ R _____	_____
	T _____ R _____	_____
2. Property Controlling in Section	S _____ T _____ R _____	_____
	S _____ T _____ R _____	_____
3. Miscellaneous Property in Sec.	S _____ T _____ R _____	_____
	S _____ T _____ R _____	_____

FILED

980058607
11/16/1998 15:15:02
REGISTER OF DEEDS
Paula Johnson
INGHAM COUNTY, MI

Register of Deeds Stamp & File Number

4. Lot No. _____, Recorded Plat _____
5. Private Claims _____

I, RON HELSEL, in a field survey on SEPTEMBER 15, 1998 do hereby certify that under requirements of P.A. 74, Michigan P.A. of 1970, the corner points mentioned in lines 1 and 2 above were in conformance with regulations and rules therefore as required in the current manual of survey instructions of the United States Department of the Interior, Bureau of Land Management or by a decree of a Court of Law and /or that the corner points mentioned in lines 3, 4 and 5 above were in conformance with the rules of the Michigan Board of Land Surveyors or by a Decree of a Court of Law; established, re-established, monumented, re-monumented, recovered, found as expressed below:

A	B	C	D	E	F	G	H	I	J	K	L	M
1												
2	6		5		4		3		2		1	
3												
4	7		8		9		10		11		12	
5												
6	18		17		16		15		14		13	
7												
8	19		20		21		22		23		24	
9												
10	30		29		28		27		26		25	
11												
12	31		32		33		34		35		36	
13												

NOTE: Not more than 4 corners, all in the same town and range, may be recorded on this certificate.

A. Description of original monument and accessories and/or subsequent restoration:

ORIGINAL MONUMENT: POST SET BY U.S. DEPUTY SURVEYOR, NAME UNKNOWN, MAR., 1825, 80.00 CHAINS WEST OF SE CORNER. WITNESSED AS: W. OAK 15", N61E, 1.5 LINKS; BEECH 13", N10.5W, 37 LINKS.


- COUNTY SURVEYOR, A.P. DRAKE, DEC. 12, 1879, VOL. 2, PAGE 181, SET A STONE FOR THE CORNER BUT DID NOT GIVE ANY WITNESSES.
- COUNTY SURVEYOR, J. McCREARY, MAY 6 & 7, 1890, VOL. 2, PAGE 235 CALLED FOR A STONE, LYNN 18", S68 3/4 W, 30 1/3 LINKS.
- P.A. 74 CORNER RECORDED IN LIBER 2, PAGE 55, MAY 22, 1972, BY O. BOSS, NO.13574. "P.K. NAIL SET - SECTION SUBDIVISION." N35W, 48.2', P.K. NAIL WEST SIDE OF POWER POLE (GONE)
N13E, 101.0', 1/2" BOLT WEST SIDE OF 36" OAK (FOUND 40" OAK AT 94.5 FEET)
S71E, 68.7', P.K. NORTH SIDE 48' ELM (GONE)
- CETA DOSSIER, FOR K-1 LEROY TWP., DATED 7-25-80, NOTED THAT THEY DUG A 10' X 10' HOLE " FOUND A 1/2" BOAT SPIKE OVER A 5/8" NAIL 1.8 FEET BELOW SURFACE OF ROAD WITH 3 PIECES OF FIRED POTTERY NEAR. 2.6 FEET SOUTH CENTERLINE OF ALLEN RD. AND 2.0 FEET EAST OF CENTERLINE OF MORRICE RD." AVERAGE DEPTH 2.5 FEET.
N5E, 91.96' NAIL & TAG, 35" OAK (FOUND); N80E, 86.21', NAIL & TAG, 20" OAK (GONE); S80E, 96.25', NAIL & TAG, 40" OAK (FOUND).
(CONTINUED ON BACK)

B. Description of corner evidence found and/or method applied in restoring or reestablishing corner:

FOUND A 10' X 10' SQUARE HOLE PATCH AT THE INTERSECTION OF ALLEN AND MORRICE ROADS. FOUND AN ILLEGIBLE CAP AND 1/2" X 24" REBAR 2.0 FEET EAST OF THE C/L OF MORRICE ROAD AND 2.0 FEET SOUTH OF THE C/L OF ALLEN ROAD. EXCAVATED THROUGH OLD ASPHALT PATCH, WHICH APPEARS TO HAVE BEEN LAID 20 YEARS AGO, DOWN 3.2 FEET TO THE OLD CLAY ROAD BED. FOUND BRICK & A FLAT STONE IN AN UPRIGHT POSITION, 4" X 18" X 8", UNDER THE 1/2" REBAR. ALSO FOUND A CAPPED 14" BOAT SPIKE LYING FLAT BETWEEN THE REBAR AND STONE. ACCEPTED THE STONE AS NOTED BY THE COUNTY SURVEYORS DRAKE AND McCREARY. RAISED STONE & SOME OF THE BRICK AND SET A STANDARD 3/4" FORM PIN AND INGHAM COUNTY DISK STAMPED P.A. 345, P.S. NO. 18994 IN A MONUMENT BOX.

C. Description of monument for corner and accessories established to perpetuate locating the position of the corner:

3/4" X 24" FORM PIN AND CAP IN MONUMENT BOX.
FOUND NAIL & TAG, #18989 (M. FOUTY), ON WEST SIDE 40" OAK (NAIL VERY SMALL) REPLACED WITH NAIL & TAG NO. 18994, AZ. 17°, 94.49 FEET
SET 1/2" BAR AND CAP 6" OFF THE BACK OF & IN THE MIDDLE OF CURB, AZ. 329°, 37.59 FEET
SET 1/2" BAR AND CAP 6" OFF THE BACK OF & IN THE MIDDLE OF CURB, AZ. 45°, 40.11 FEET
SET NAIL & TAG, NORTH SIDE OF 40" OAK IN BLAZE MARK, AZ. 148°, 95.72 FEET
FOUND FOUTY BAR & CAP, 33.0 FEET SOUTH OF P.K. NAIL (K-1 LEROY TWP.), AZ. 148°, 39.69 FEET
K-1 LEROY TWP. 3/4" FORM PIN AND STANDARD DISK, AZ. 88°, 21.12 FEET

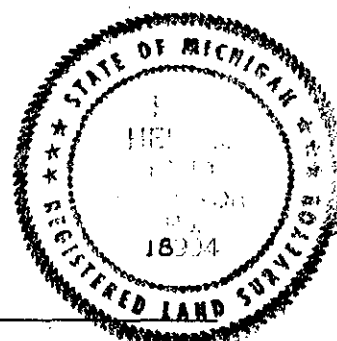

Signed by Ron Helsel
Surveyor's Michigan License No. 18994

Date Nov. 3, 1998

SURVEY &
RECALCULATION

DEC 17 1998

Liber 9 Page 399

SECTION

5) P.A. 132 SURVEYS, DATED MAY 22, 1972, LIBER 403; DATED OCT. 7, 1972, LIBER 1, PAGES 563 & 564; DATED MAR. 6, 1973, LIBER 1, PAGES 1006, 1007 & 1008; AND DATED NOV. 12, 1973, LIBER 1, PAGE 1094 7 1095, BY O. BOSS, NO. 13574 ALL REFER TO THE P.K. NAIL AND HAVE THE SAME WITNESSES AS 3-A ABOVE.

RECEIVED DE 22 1998
11:00 AM
13574

DEC 17 1998 399