

SURVEY & REMONUMENTATION

DEC 0 8 1999

Liber 9 Page 471

LAND CORNER RECORDATION CERTIFICATE
Filing Requirement of Act 74, Mich. P.A. 1970
LOCKE TOWNSHIP

SECTION

For corners in

INGHAM (County)

Located In: Corner Code #

- 1. Public Land Survey T 4N R 2E L-11
2. Property Controlling in Section S T R
3. Miscellaneous Property in Sec. S T R

- 4. Lot No. Recorded Plat
5. Private Claims

FILED

990043534
08/26/1999 09:07:59
REGISTER OF DEEDS
Paula Johnson
INGHAM COUNTY, MI

Register of Deeds Stamp & File Number

I, RON HELSEL, in a field survey on AUG. 11, 1999 do hereby state that under requirements of P.A. 74, Michigan P.A. of 1970, the corner points mentioned in lines 1 and 2 above were in conformance with regulations and rules therefore as required in the current manual of survey instructions of the United States Department of the Interior, Bureau of Land Management or by a decree of a Court of Law and for that the corner points mentioned in lines 3, 4 and 5 above were in conformance with the rules of the Michigan Board of Land Surveyors or by a Decree of a Court of Law; established, re-established, monumented, recovered, found as expressed below:

NOTE: Not more than 2 corners, all in the same town and range, may be recorded on this certificate.

A. Description of original monument and accessories and/or subsequent restoration:

ORIGINAL MONUMENT: POST, SET BY J. WAMPLER, U.S. DEPUTY SURVEYOR, 1826 AT AVG. DISTANCE 40.60 CHAINS. IW, 9", N20E 16 LINKS; IW, 9", S23W, 6.5 LINKS. 1) COUNTY SURVEYOR, J. McCREARY, VOL. 3, PAGE 219, MAY 6 & 7, 1890, CITED JACKSON'S OLD BEARINGS, W. OAK, 18", 23 LINKS; S61-3/4E & W. OAK, N65-1/4E, 16.5 LINKS. (NOTE: I DID NOT FIND ANY RECORD IN THE INGHAM CO. RECORDS BY CO. SURVEYOR JACKSON IN THIS SECTION OF LOCKE TOWNSHIP).

2) P.A. 132 SURVEY RECORDED IN LIBER 7, PAGE 616, DATED JAN. 31, 1995, BY M. MAHIEU, P.S. 28414, IDENTIFIES THIS CORNER AS A 1/2" IRON W/CAP. WITNESSED AS: N&T, S. SIDE 18" MAPLE, EAST, 9.35' (FOUND N&T GROWN IN BARK) N&T, S. SIDE 8" OAK, N80°W, 12.83' (FOUND OAK, NO TAG) N&T, N. SIDE 16" MAPLE, 15.74' (FOUND N&T GROWN IN BARK) N&T, W. SIDE 14" MAPLE, 6.11" (FOUND N&T GROWN IN BARK)

CHISELED OUT THE ABOVE TAGS AND FOUND THEM TO BE NO. 17640 (G. YOUNG). THEY APPEAR TO HAVE BEEN SET AROUND 20 YEARS AGO BY THE DEPTH OF THE BARK.

DID NOT FIND ANY SUBSEQUENT P.A. 132 SURVEYS OR P.A. 74, L.C.R.C. FOR THIS CORNER.


B. Description of corner evidence found and/or method applied in restoring or reestablishing corner:

MET WITH AND TO TALKED TO A MR. MORRIS LOTT, OWNER OF THE PROPERTY DIRECTLY SOUTH OF THE CORNER, HE POINTED OUT THE 1/2" IRON BAR WITH M. MAHIEU'S CAP NO. 28414 LOCATED AT THE INTERSECTION OF AN EAST-WEST BARBED WIRE FENCE AND WITH FENCE REMNANTS TO THE NORTH. MR. LOTT POINTED OUT THE AREA OF SOME FIELD STONES AND MENTIONED THAT WAS THE AREA OF WHERE AN ANCHOR POST WAS WHEN HE BOUGHT THE PROPERTY OVER 50 YEARS AGO.. EXCAVATED DOWN THROUGH A CIRCLE OF STONES AND FOUND THE ROTTED REMAINS OF A WOOD POST NEXT TO AN OLD PLOW POINT, DATED AND IDENTIFIED AS MOORE, 9-5-1899. MR. LOTT IDENTIFIED THE PLOW AS A HORSE DRAWN AND WAS AMAZED THAT THE DATE AS STAMPED WAS STILL LEGIBLE. MR. LOTT IS A COLLECTOR OF PLOW POINTS AND READILY ACCEPTED THE POINT AS OFFERED TO HIM, SINCE THERE WAS NO DOUBT IN MY MIND THAT IT REPRESENTED THE POSITION OF THE McCREAY CORNER SET IN 1890. CORNER IS LOCATED 6 FEET SOUTH AND 2.5 WEST MORE OR LESS FROM THE CORNER IDENTIFIED BY 2-A ABOVE. SET A 3/4" X 24" FORM PIN AND 2.5" ALUMINUM CAP STAMPED P.A. 345, P.S. NO. 18994 IN THE POSITION OF THE PLOW POINT.

C. Description of monument for corner and accessories established to perpetuate locating the position of the corner:

3/4" FORM PIN AND CAP NO. 18994, 6 FEET SOUTH OF EAST-WEST FENCE LINE. SET NAIL & TAG NO. 18994 ABOVE YOUNG TAG, S/SIDE 18" MAPLE, AZ. 77°, 12.57 FEET. SET NAIL & TAG NO. 18994, S/SIDE 8" RED OAK, AZ. 333°, 14.78 FEET. SET NAIL & TAG NO. 18994, S/SIDE 18" MAPLE, AZ. 290°, 50.04 FEET. SET NAIL & TAG NO. 18994, SE/SIDE 20" TWIN RED OAK, AZ. 76.24 FEET. N30°E, 6.67 FEET 1/2" BAR & CAP NO. 28414

Grid table with columns A-L and rows 1-13. A dot is present in cell J11.

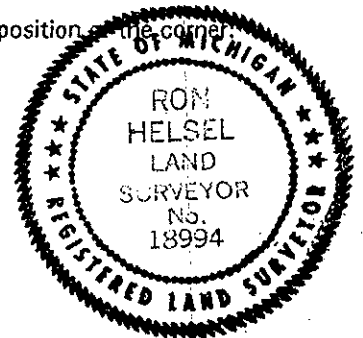

Signed by Ron Helsel
Surveyor's Michigan License No. 18994

Date Aug. 21, 1999