

**SURVEY &
REMONUMENTATION**

DEC 9 1999

Liber 9 Page 472

SECTION

**LAND CORNER RECORDATION CERTIFICATE
Filing Requirement of Act 74, Mich. P.A. 1970
LOCKE TOWNSHIP**

FILED

990043535
08/26/1999 09:08:01
REGISTER OF DEEDS
Paula Johnson
INGHAM COUNTY, MI

For corners in

<u>INGHAM</u> (County)	Located In:	Corner Code #
1. Public Land Survey	T <u>4N</u> R <u>2E</u>	<u>L-12</u>
	T _____ R _____	_____
	T _____ R _____	_____
	T _____ R _____	_____
2. Property Controlling in Section	S _____ T _____ R _____	_____
	S _____ T _____ R _____	_____
3. Miscellaneous Property in Sec.	S _____ T _____ R _____	_____
	S _____ T _____ R _____	_____

Register of Deeds Stamp & File Number

4. Lot No. _____, Recorded Plat _____
5. Private Claims _____

I, RON HELSEL, in a field survey on JULY 7, & AUG. 11, 1999 do hereby state that under requirements of P.A. 74, Michigan P.A. of 1970, the corner points mentioned in lines 1 and 2 above were in conformance with regulations and rules therefore as required in the current manual of survey instructions of the United States Department of the Interior, Bureau of Land Management or by a decree of a Court of Law and /or that the corner points mentioned in lines 3, 4 and 5 above were in conformance with the rules of the Michigan Board of Land Surveyors or by a Decree of a Court of Law; established, re-established, monumented, recovered, found as expressed below:

	A	B	C	D	E	F	G	H	I	J	K	L	M
1													
2	6		5		4		3		2		1		
3													
4	7		8		9		10		11		12		
5													
6	18		17		16		15		14		13		
7													
8	19		20		21		22		23		24		
9													
10	30		29		28		27		26		25		
11													
12	31		32		33		34		35		36		
13													

NOTE: Not more than 2 corners, all in the same town and range, may be recorded on this certificate.

A. Description of original monument and accessories and/or subsequent restoration:
CORNER NOT SET IN ORIGINAL GOVERNMENT SURVEY OF 1826.


- 1) COUNTY SURVEYOR, J. McCREARY VOL. 3, PAGE 219, MAY 6 & 7, 1890, CALLED FOR A HEWED RED ELM STAKE WITNESSED AS: W. OAK, 48", N51°W, 1.5 LINKS; R. ELM, 16", N72-1/4E, 47 LINKS.
- 2) OSCAR BOSS, P.S. NO. 13574, RECORDED A P.A. 74 L.C.R.C. DATED 10-23-1972, IN LIBER 2 OF CORNERS, PAGE 119. TOGETHER WITH A P.A. 132 SURVEY DATED OCT. 7, 1972 AND RECORDED IN LIBER 1 OF SURVEYS, PAGE 563 & 564. BOTH CALLED FOR, 1/2" IRON SET FENCE LINE & OCCUPATION".
S55°W, 22.50, NAIL SOUTH SIDE 20" CHERRY (FOUND DEAD CHERRY STILL STANDING)
NORTH, 8.30, NAIL WEST SIDE 9" OAK (FOUND 16" OAK)
EAST, 8.63, NAIL NORTH SIDE 10" MAPLE (FOUND 14" MAPLE)
NO OTHER SURVEYS WERE FOUND REFERENCED TO THIS CORNER.

B. Description of corner evidence found and/or method applied in restoring or reestablishing corner:

FOUND A 1/2" IRON BAR AND BOSS CAP AT THE BASE OF AN OLD ROTTED ANCHOR POST ON LINE WITH FENCES IN ALL THE CARDINAL DIRECTIONS. RECOVERED THE NORTH 1/4 CORNER OF THE SECTION AND FOUND THE CENTER OF SECTION BAR AS SET BY SURVEYOR O. BOSS TO BE WITHIN 2 FEET OF BEING ON LINE WITH AN ANCHOR POST SET AT THE SOUTHEAST CORNER OF PROPERTY OWNED BY MR. MORRIS LOTT, A 50 YEAR OWNER OF THE NORTH 1/2 OF THE NW 1/4 OF SECTION 36. HE POINTED THE POST OUT TO THIS SURVEYOR AS A REPLACEMENT OF AN EXISTING ROTTED POST WHEN THE FENCE WAS REMOVED BETWEEN HIS PROPERTY AND THE FARM TO THE SOUTH OF HIS, SEVERAL YEARS AGO. EXCAVATED AROUND THE BOSS CORNER AND THE ANCHOR POST BUT DID NOT FIND ANY EVIDENCE OF A PREVIOUS CORNER. IN LIEU OF THE REMARKABLE STRAIGHTNESS OF A LINE BETWEEN THE ABOVE DESCRIBED CORNERS AND SINCE THE SOUTH 1/4 CORNER OF THE SECTION WAS DEEMED LOST, I BELIEVE AND EXCEPTED THE POSITION OF THE BOSS IRON AS FAITHFUL PERPETUATION OF THE McCREARY STAKE AND SET A STANDARD INGHAM COUNTY MONUMENT. POSITION IS 8 FEET MORE LESS WEST OF AND 8 FEET MORE OR LESS NORTH OF LINES BETWEEN THE ADJACENT 1/4 CORNERS.

C. Description of monument for corner and accessories established to perpetuate locating the position of the corner:

- SET 3/4" X 24" IRON BAR AND 2.5" ALUMINUM CAP STAMPED P.A. 345; P.S. NO. 18894 AT INTERSECTION OF FENCES
SET NAIL & TAG NO. 18994 WEST/SIDE 40" W. CHERRY, AZ. 06°, 25.97 FEET
SET NAIL & TAG NO. 18994 SOUTH/SIDE 14" MAPLE, AZ. 106°, 8.84 FEET
SET NAIL & TAG NO. 18994 SOUTHEAST/SIDE 12" MAPLE, AZ. 62°, 27.67 FEET
SET NAIL & TAG NO. 18994 NORTH/SIDE 18" MAPLE, AZ. 260°, 36.12 FEET
MEASURED WEST, 2650.02 FEET TO K-12
MEASURED SOUTH, 2639.31 FEET TO L-13
MEASURED EAST, 2691.49 FEET TO M-12
MEASURED NORTH, 2638.8 FEET ± TO L-11

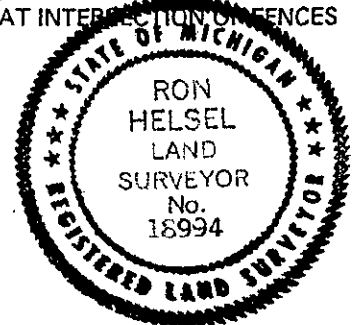

Signed by Ron Helsel
Surveyor's Michigan License No. 18994

Date Aug 21, 1999