

DEC 17 1998

SECTION

LAND CORNER RECORDATION CERTIFICATE
Filing Requirement of Act 74, Mich. P.A. 1970

Liber 9 Page 381

For corners in

<u>INGHAM</u> (County)	Located In: LOCKE TOWNSHIP	Corner Code # M-12
1. Public Land Survey	T <u>4N</u> R <u>2E</u>	<u>M-12</u>
	T _____ R _____	_____
	T _____ R _____	_____
	T _____ R _____	_____
2. Property Controlling in Section	S _____ T _____ R _____	_____
	S _____ T _____ R _____	_____
3. Miscellaneous Property in Sec.	S _____ T _____ R _____	_____
	S _____ T _____ R _____	_____

FILED

980053157
10/19/1998 14:42:10
REGISTER OF DEEDS
Paula Johnson
INGHAM COUNTY, MI

Register of Deeds Stamp & File Number

4. Lot No. _____, Recorded Plat _____
5. Private Claims _____

I, RON HELSEL, in a field survey on SEPTEMBER 15, 1998 do hereby certify that under requirements of P.A. 74, Michigan P.A. of 1970, the corner points mentioned in lines 1 and 2 above were in conformance with regulations and rules therefore as required in the current manual of survey instructions of the United States Department of the Interior, Bureau of Land Management or by a decree of a Court of Law and /or that the corner points mentioned in lines 3, 4 and 5 above were in conformance with the rules of the Michigan Board of Land Surveyors or by a Decree of a Court of Law; established, re-established, monumented, re-monumented, recovered, found as expressed below:

1	A	B	C	D	E	F	G	H	I	J	K	L
2		6		5		4		3		2		1
3												
4		7		8		9		10		11		12
5												
6		10		17		16		15		14		13
7												
8		19		20		21		22		23		24
9												
10		30		29		28		27		26		25
11												
12		31		32		33		34		35		36
13												


NOTE: Not more than 4 corners, all in the same town and range, may be recorded on this certificate.

A. Description of original monument and accessories and/or subsequent restoration:
ORIGINAL MONUMENT: POST SET BY AN UNKNOWN DEPUTY SURVEYOR, FEB. 1824. SURVEYED FROM NORTH TO SOUTH. ELM 3" S54 1/2W 2 1/2 LINKS

- 1) COUNTY SURVEYOR JOHN McCREARY, VOL.2, PAGE 235, 1890, CALLED FOR A STAKE: WITNESS B.T. 2" SUGAR, S33 1/2E, 64 LINKS.
- 2) THE INGHAM COUNTY CETA CREW EXCAVATED A 10' X 10' HOLE IN THE PROBABLE AREA OF THIS CORNER ON 9-29-78 & 10- 2-78 AND DID NOT FIND ANY EVIDENCE OF A PREVIOUS CORNER. IT WAS DEEMED AT THAT TIME AS A LOST CORNER.
- 3) DID NOT FIND ANY FURTHER RECORDS PUBLIC OR PRIVATE THAT REFERRED TO THIS CORNER.

B. Description of corner evidence found and/or method applied in restoring or reestablishing corner:
AREA OF CORNER IN A 3' FILL FOR HERRINGTON ROAD. TRAVERSED BETWEEN M-11 AND M-13 AND AGREED WITH THE INGHAM COUNTY CETA CREW THAT THIS WAS A LOST CORNER. SET A 3/4" X 24" FORM PIN AND STANDARD INGHAM COUNTY DISK STAMPED P.A. 345, P.S. NO. 18994 AT THE MID-POINT AND ON LINE BETWEEN THE NORTHEAST AND THE SOUTHEAST CORNERS OF SECTION 36, IN A MONUMENT BOX. CORNER 3.0 FEET WEST OF CENTERLINE OF HERRINGTON ROAD AND 14.76 FEET NORTH OF A-12 OF CONWAY TWP., T4N, R3E, LIVINGSTON CO., AS RECORDED BY A. WILLIAMS P.S. NO. 21275.

C. Description of monument for corner and accessories established to perpetuate locating the position of the corner:
24" X 3/4" FORM PIN AND STANDARD INGHAM CO. DISK, 3.0 FEET WEST OF THE CENTERLINE OF HERRINGTON ROAD.
FOUND 1/2" PIPE IN 4" SQUARE CONCRETE BASE, AZ. 120°, 33.34 FEET
FOUND NAIL & TAG NO. 12034, (F.N. WHITE), WEST/SIDE 26" OAK, AZ. 23°, 73.02 FEET
SET NAIL & TAG NO. 18994, SE/SIDE 10" ASH, AZ. 236°, 28.91 FEET
SET NAIL & TAG NO. 18994, WEST/SIDE 8" OAK, AZ. 23°, 92.19 FEET
SET NAIL & TAG NO. 18994, EAST/SIDE 24" COTTONWOOD, AZ. 349°, 78.94 FEET
1/2" BAR SOUTH, 14.76 FEET & 0.76 FEET, EAST OF THE STANDARD LINE, AS RECORDED IN LIBER 1, PAGE 1110, LIVINGSTON COUNTY, DEEDS AS THE WEST 1/4 CORNER SECTION 31, CONWAY TWP. (A-12), T4N, R3E
MEASURED NORTH 2639.00 FEET TO NE CORNER SECTION 36
MEASURED SOUTH 2639.00 FEET TO SE CORNER SECTION 36

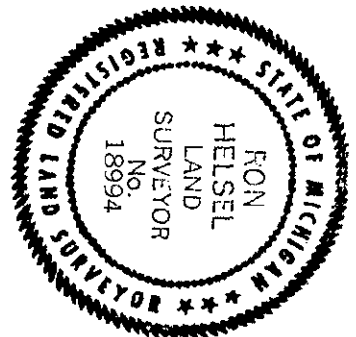

Signed by Ron Helsel
Surveyor's Michigan License No. 18994

Date Oct 2, 1998

P.A. 345 INGHAM COUNTY
PEER APPROVED 9/22/98 M