

NOV 15 1994

LAND CORNER RECORDATION CERTIFICATE
Filing Requirement of Act 74, Mich. P.A. 1970

MAY 10 8 50 AM '94

COMMISSION

For corners in
Ingham
(County)

Located In:	Corner Code #:
T <u>4N</u> R <u>2W</u>	<u>J-1</u>
T _____ R _____	_____
T _____ R _____	_____
T _____ R _____	_____
T _____ R _____	_____
S _____ T _____ R _____	_____
S _____ T _____ R _____	_____
S _____ T _____ R _____	_____
S _____ T _____ R _____	_____

REGISTER OF DEEDS
Dennis S. Johnson
INGHAM COUNTY, MICH.

Register of Deeds Stamp & File Number

4. Lot No. _____, Recorded Plat _____
5. Private Claims _____

	A	B	C	D	E	F	G	H	I	J	K	L	M
2	6	5	4	3	2	1							
3													
4	7	8	9	10	11	12							
5													
6	18	17	16	15	14	13							
7													
8	19	20	21	22	23	24							
9													
10	30	29	28	27	26	25							
11													
12	31	32	33	34	35	36							
13													

I, Larry A. Bryan, in a field survey on March 10, 19 94, do hereby certify that under requirements of P.A. 74, Michigan P.A. of 1970, the corner points mentioned in lines 1 and 2 above were in conformance with regulations and rules therefore as required in the current manual of survey instructions of the United States Department of the Interior, Bureau of Land Management or by a decree of a Court of Law and/or that the corner points mentioned in lines 3, 4 and 5 above were in conformance with the rules of the Michigan Board of Land Surveyors or by a Decree of a Court of Law; established, re-established, monumented, re-monumented, recovered, found as expressed below:

NOTE: Not more than 4 corners, all in the same town and range, may be recorded on this certificate.

A. Description of original monument and accessories and/or subsequent restoration:

J-1,

1. Corner not set in Original Government Survey.
2. Corner identified in a survey by T.J. Brown, County Surveyor, on November 19, 1874 (vol. 2, Page 115 County Surveyor Records) as "a post from which a Beech 11 in. diameter bears S39 1/2W 33 1/8 lks, and a Sugar 10 in diameter bears N49W 13 lks".

(Continued on Back)


B. Description of corner evidence found and/or method applied in restoring or reestablishing corner:

J-1, Investigation at this corner revealed a copperweld in monument box 9.58' West of the West edge of South bound lane of U.S. 127. A nail and tag #18998 was found in top of a guard rail post N20°W 23.10', and in top of a guard rail post South 21.45' along with a copperweld in monument box, J-13 Dewitt Township, West 9.42' as listed in item #6. Measured 2623.44' to K-1 Lansing Township and 2635.41' to K-13 Dewitt Township. Accepted copperweld in monument box as the perpetuated location of J-1.

C. Description of monument for corner and accessories established to perpetuate locating the position of the corner:

J-1, T4N-R2W
Found copperweld in monument box as noted above.
Found nail & tag #18998 in top of guard rail post, N20°W, 23.10'.
Found nail & tag #18998 in top of guard rail post, South, 21.45'.
Center of "+" in station 910+00 stamped in West edge of South bound U.S.127, N40°E, 15.00'.
Center of "+" in station 909+70 stamped in West edge of South bound U.S. 127, S35°E, 22.51'.

Signed by Larry A. Bryan
Surveyor's Michigan License No. 25832

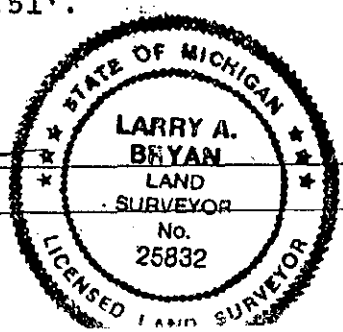

Date 4-15-94

0211

PART "A" CONTINUED

3. Corner referred to in a resurvey of Lansing Township by R.J. Robb, County Surveyor, in August and September 1909 (vol. 3, Page 218 and 219 County Surveyor Records) and identified as a "cement post 3" square at top and 4" square on bottom and 2.5 feet long, witnessed by Elm 30" S-W no distance given".
4. Corner identified by C.E. Smith, survey chief Michigan State Highway Department, January 1965, on Government Monument Witness Form 280 as "one inch pipe", witnessed to:
 S62E 36.56 14" twin Basswood.
 S81E 13.59 13" Hick.
 S19E 23.78 17" Oak.
5. Corner identified as 1 inch pipe with witnesses shown in item #4 on Ingham County Road Commission grid map, revised January, 1972 .
6. Corner recorded by Ronnie M. Lester P.S. #18998 on February 5, 1980 in Liber 6 of Corners, Page 53 Ingham County Records, as having found copperweld in monument box ± 9.42 feet East of J-13 Dewitt Township, T5N, R2W, on tree/fence line East and West, and ± 10.0 feet West of West edge of Southbound lane of US 127. Accepted copperweld in monument box and witnessed to:
 Nail and Tag, #18998, top of wooden guard rail post, NNW, 23.10'.
 Nail and tag, #18998, top of wooden guard rail post, South, 21.43'.
 East side of the West leg of sign Post, WNW, 10.17'.
 West edge of concrete lane on Southbound US 127, East, 9.58'.
 Copperweld in monument box, J-13, Dewitt Twp., T5N, R2W, West 9.42'.
7. Corner referenced by Ronnie M. Lester P.S. #18998 on February 5, 1980 and recorded in Liber 2 of Corners, Page 287 Clinton County Records as having found copperweld in monument box 9.42 feet East of J-13, South 1/4 corner of Section 35, T5N, R2W, Dewitt Township, Clinton County, Michigan.
8. Corner shown on a survey by Douglas K. Richardson P.S. #31603 on March 12, 1987 and recorded in Liber 3 of Surveys, Page 89 and 90, Clinton County Records as having found a copperweld in monument box and listing witnesses in item #6.