

NOV 15 1994

LAND CORNER RECORDATION CERTIFICATE
Filing Requirement of Act 74, Mich. P.A. 1970

MAY 10 8 51 AM '94

COMMISSION

For corners in

Ingham

(County)

Located In:

Corner Code #

- 1. Public Land Survey T 4N R 2W J-2
- T _____ R _____
- T _____ R _____
- T _____ R _____
- 2. Property Controlling S _____ T _____ R _____
- in Section S _____ T _____ R _____
- 3. Miscellaneous S _____ T _____ R _____
- Property in Sec. S _____ T _____ R _____

REGISTER OF DEEDS
Paula J. Johnson
INGHAM COUNTY, MICH.

Register of Deeds Stamp & File Number

- 4. Lot No. _____, Recorded Plat _____
- 5. Private Claims _____

	A	B	C	D	E	F	G	H	I	J	K	L	M
2	6	5	4	3	2	1							
3													
4	7	8	9	10	11	12							
5													
6	18	17	16	15	14	13							
7													
8	19	20	21	22	23	24							
9													
10	30	29	28	27	26	25							
11													
12	31	32	33	34	35	36							
13													

I, Larry A. Bryan, in a field survey on March 10, 19 94, do hereby certify that under requirements of P.A. 74, Michigan P.A. of 1970, the corner points mentioned in lines 1 and 2 above were in conformance with regulations and rules therefore as required in the current manual of survey instructions of the United States Department of the Interior, Bureau of Land Management or by a decree of a Court of Law and/or that the corner points mentioned in lines 3, 4 and 5 above were in conformance with the rules of the Michigan Board of Land Surveyors or by a Decree of a Court of Law; established, re-established, monumented, re-monumented, recovered, found as expressed below:

NOTE: Not more than 4 corners, all in the same town and range, may be recorded on this certificate.

A. Description of original monument and accessories and/or subsequent restoration:
J-2,

- 1. Corner not set in Original Government Survey.
- 2. Corner identified in a survey by T.J. Brown, County Surveyor, on November 19, 1874 (vol. 2, page 115 County Surveyors Records) as "a post from which a Elm 11 in. diameter bears S78W 35 1/2 lks and a Elm 7 in. diameter bears N31 3/4W 40 lks".

(Continued on Back)


B. Description of corner evidence found and/or method applied in restoring or reestablishing corner:

J-2, Investigation at this corner revealed a 18" square concrete post with a 1 1/4" steel pipe in the center ±342' West of U.S. 127 right of way fence. A nail and tag #16053 in the North side of a 30" Hickory, S20°E 113.16' and a 24" Oak, no tag visible, West ±92.5' as noted in item #6. Accepted concrete post with 1 1/4' pipe as the perpetuated location of J-2.

C. Description of monument for corner and accessories established to perpetuate locating the position of the corner:

J-2, T4N-R2W
Found 18" square concrete post with 1 1/4" pipe in center as noted above.
Found nail & tag #16053 in the North side 30" Hickory, S20°E, 113.16'.
Set nail & tag #25832 in the South side 20" Willow East 79.03'.
Set nail & tag #25832 in the North side 12" Elm, S80°W, 31.62'.
Set nail & tag #25832 in the North side 24" Oak, West, 92.47'.
Found bar and cap #16053, East 336.03'.

Signed by Larry A. Bryan
Surveyor's Michigan License No. 25832

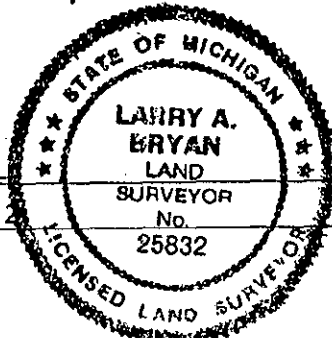

Date 4-15-94

PART "A" CONTINUED

3. Corner identified in a survey by A.P. Drake, County Surveyor, on December 22, 1881 (vol. 2, page 203 County Surveyor Records) as "a post from which a Elm 11 in. diameter bears S78W 351/2 lks and a Elm 7 in. diameter bears N31 3/4W 40 lks".
4. Corner identified in a survey by John McCreary, County Surveyor, on May 30 and 31, 1890 (vol. 2, page 237 County Surveyor Records) as "a stone and iron, Sugar 16 N1 1/2W 19 1/2 lks, Maple 12 N61 1/2E 47 lks".
5. Corner identified by Clifford Smith, survey chief Michigan State Highway Department, February, 1965, on Government Monument Witness Form 280 as "found 15 inch square concrete post with 2 inch pipe in center for the center of section 2 Lansing twp. Ingham County" witnessed to: 27" Elm S05W 13.20', 22" Elm S29W 14.20', 11" Elm N82W 19.92'.
6. Corner recorded by James E. Stephens P.S. #16053 on May 19, 1977 in Liber 4 of Corners, Page 62 Ingham County Records as "a 18" square corner fence post with a 1 1/4" pipe in the center was found at the intersection of four old fences", witnessed to survey tag #16053 nailed to the North side of a 24" Oak tree, West 91.46 feet, Survey tag #16053 nailed to the East side of a 24" Hickory tree, South 116.92 feet, Survey tag nailed to the Northeast side of a 30" Hickory tree S40°E 113.08 feet.
7. Corner shown on a survey by James E. Stephens P.S. #16053 dated June 18, 1987, recorded in Liber 5 of Surveys, Page 232 and 233 Ingham County Records and on August 31, 1989, recorded in Liber 5 of Surveys, Page 1152 through 1159 Ingham County Records, with the same monument and witnesses as listed in item #6.