


5 1/4 Cor. Sec 14, T^R (URBANDALE)

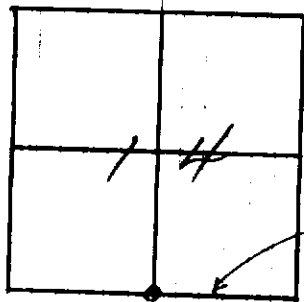

33?

2621.02

● Conc. mon. with 1/2" steel rod.

631 Charles, NE Cor. house, N 80° W. 46.0'

7" B. Elder N. 60° E. 29.08'

21" elm S 40° W. 44.92'

from S.H.D. Copied 5/63.