

LAND CORNER RECORDATION CERTIFICATE

FILING REQUIREMENT OF ACT 74, MICH. P.A.1970

FOR CORNERS OF--	LOCATED IN--	CORNER CODE NUMBER
1. PUBLIC LAND SURVEY <u>20, 18</u> T. <u>5</u> N. <u>5</u> W.		<u>D-7, C-6</u>
2. PROPERTY CONTROLLING IN SECTION _____, T. _____, S., R. _____ E. W.		
3. MISCELLANEOUS PROPERTY IN SECTION _____, T. _____, S., R. _____ E. W.		
4. LOT NO. _____, RECORDED PLAT _____		
5. PRIVATE CLAIMS _____		

REGISTER OF DEEDS STAMP AND
FILING NUMBER

I, Russell Roon, do hereby certify that under requirements of P.A. 74, Michigan P.A. of 1970, the corner points mentioned in lines 1 and 2 above were, in a field survey on November, 1978, established, re-established, monumented, re-monumented, recovered or restored as expressed below and in conformance with regulations and rules therefore as required in the current manual of survey instructions of the United States Department of the Interior, Bureau of Land Management or by a decree of a court of law. Furthermore, that the corner points mentioned in lines 3, 4 and 5 above were, in a field survey on _____, 19____, found, recovered, restored, established or re-established as expressed below and in conformance with the rules of the Michigan State Board of Registration for Land Surveyors or, by a Decree of a Court of law:

A. Description of original monument and accessories and/or subsequent restoration:

B. Description of corner evidence found and/or method applied in restoring or re-establishing corner:

D-7 Found clay cylinder. Placed 3/4" capped iron R.L.S. #13593. C-6 Found stone.

C. Description of monument for corner and accessories established to perpetuate locating the position of the corner:

D-7 3/4" capped iron.	C-6 Stone	
32" Oak, N 52° W, 30.60'	N 11° E, 11.83'	9" Hickory
25" Walnut, S 17° W, 23.24'	S 35° E, 21.67'	14" Oak
14" Walnut, N 67° W, 40.06'	S 29° W, 20.73'	17" Twin Hackberry
25" Twin Walnut, S 52° E, 42.08'	N 53° W, 22.06'	8" Hackberry

SIGNED BY _____ DATE _____


SURVEYOR'S MICHIGAN REGISTRATION NO. _____

(SEAL)

FOR STATE AND UNITED STATES AGENCIES:

SIGNED BY _____ DATE _____

APPROVED AND SIGNED BY Russell A. Roon DATE _____
MICHIGAN REGISTERED LAND SURVEYOR

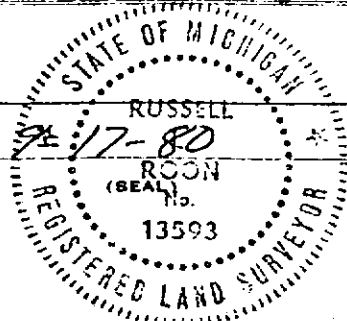

SURVEYOR'S MICHIGAN REGISTRATION NO. 13593

PAGE 46