

DEC 20 2000

LAND CORNER RECORDATION CERTIFICATE
Filing Requirement of Act 74, Mich. P.A. 1970

SECTION

For corners in IONIA
(County)

Located In:


Corner Code #



LIBER 4

PAGE 141

- 1. Public Land Survey T5 N R6 W I-9
T R
T R
T R
- 2. Property Controlling in Section S T R
S T R
- 3. Miscellaneous Property in Sec. S T R
S T R
- 4. Lot No. , Recorded Plat
- 5. Private Claims

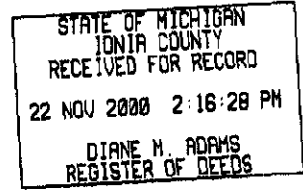

Register of Deeds Stamp & File Number

	A	B	C	D	E	F	G	H	I	J	K	L	M
1													
2	6	5	4	3	2	1							
3													
4	7	8	9	10	11	12							
5													
6	18	17	16	15	14	13							
7													
8	19	20	21	22	23	24							
9													
10	30	29	28	27	26	25							
11													
12	31	32	33	34	35	36							
13													

I, MARINUS MULDER, in a field survey on MAY 24 2000, do hereby certify that under requirements of P.A. 74, Michigan P.A. of 1970, the corner points mentioned in lines 1 and 2 above were in conformance with regulations and rules therefore as required in the current manual of survey instructions of the United States Department of the Interior, Bureau of Land Management or by a decree of a Court of Law and/or that the corner points mentioned in lines 3, 4 and 5 above were in conformance with the rules of the Michigan Board of Land Surveyors or by a Decree of a Court of Law; established, re-established, monumented, re-monumented, recovered, found as expressed below:

NOTE: Not more than 4 corners, all in the same town and range, may be recorded on this certificate.

A. Description of original monument and accessories and/or subsequent restoration:
THIS CORNER WAS FIRST ESTABLISHED BY U.S. DEPUTY SURVEYOR, LUCIUS LYON IN 1827. A WOOD POST WAS SET AND WITNESSED BY: A 26" ELM S 32° E 15 LINKS, AND A 10" BEECH N 20° E 5 LINKS.

PERPETUATION: D.C. CRAWFORD FORMER IONIA COUNTY SURVEYOR PERFORMED A SURVEY OF SECTION 23, T5N-R6W, DECEMBER 11-13, 1887, RECORDED ON PAGE 384 OF VOLUME 3, IONIA COUNTY SURVEYORS RECORDS. CRAWFORD NOTED HE FOUND THE OLD CORNER, BUT GAVE NO OTHER INFORMATION. CRAWFORD ALSO PERFORMED A SURVEY OF SECTION 26, T5N-R6W, SEPTEMBER 4-6, 1883, RECORDED ON PAGE 318 OF VOLUME 1 IONIA COUNTY SURVEYORS RECORDS. CRAWFORD NOTED HE FOUND THE OLD CORNER STONE FOR I-9.

THE IONIA COUNTY ROAD COMMISSION IMPROVED AND PAVED SUNFIELD HIGHWAY IN 1964 PROJECT NO. CS34-71. THE ROAD PLANS ON SHEET 3 CALL FOR AN IRON.

THE IONIA COUNTY ROAD COMMISSION HAS WITNESSES FOR I-9 IN THE WITNESS INDEX SHEETS AS FOLLOWS: "IRON 1963"-CORNER FENCE POST NE 34.65 FEET; CENTER OF TILE SE. 44.80 FEET; SIGN POST SW. 46.85 FEET.

B. Description of corner evidence found and/or method applied in restoring or reestablishing corner:
AT THE INTERSECTION OF SUNFIELD HIGHWAY AND MUSGROVE HIGHWAY FOUND A 3/4"x12" BOATSPIKE. BELOW THIS FOUND REMAINS OF ANOTHER BOATSPIKE. AT A DEPTH OF 26" FOUND A STEEL FENCE POST 20" LONG. NO OTHER EVIDENCE WAS FOUND. NO COUNTY WITNESS OBJECTS REMAIN.

C. Description of monument for corner and accessories established to perpetuate locating the position of the corner:
REPLACED EXISTING MONUMENTATION WITH A 7/8"x24" STEEL ROD WITH A 4" DIAMETER ALUMINUM CAP STAMPED - "IONIA COUNTY - P.S. 25863" WITNESSED BY:

- NAIL AND TAG E. SIDE 4"x4" SIGN POST S 60° W 54.07'
- NW. CORNER OF HOUSE FOUNDATION S 32° E 144.75'
- TOP CENTERLINE M.B.T. BOX N 9° W 122.22'
- TOP CENTERLINE CONCRETE PROJECT MARKER S 59° E 49.31'

Signed by Marinus A. Mulder Date 11-8-00
Surveyor's Michigan License No. 25863

FORM APPROVED BY MICHIGAN STATE BOARD OF LAND SURVEYORS, JAN. 28, 1971

REVISED MAY 14, 1979
REVISED JAN., 1983
ADAPTED FOR WORD PROCESSING MARCH, 1993



Ratified by Peer Group
P.A. 345 Ionia County

Date 7-19-2000
Marinus A. Mulder, Chairman