
370 L O 2000

LAND CORNER RECORDATION CERTIFICATE

LIBER 4 PAGE 118

		Filing Requirement of A	ct 74, Mich. P.A. 19	170 LIB	ER -	† PAI	£ .	. 🕝				
For corners in 10NIA	Located In:	Corner Code #		STATE OF MICHIGAN IONIA COUNTY RECEIVED FOR RECORD								
	т <u>ем</u> R <u>5W</u>		K-3			23	NOV S	9 3:0	8 P.M.	1		
1. Public Land Survey	T R	R			UIANE N. ADAMS REGISTER OF DEEDS Register of Deeds Stamp & File Number							
2. Property Controlling S	TRR			Regis	ster (of Dec	ds Sta	mp & 	File Nu 	TWDe:		
in Section S 3. Miscellaneous S	' " T R											
Property in Sec. S					1 A	B C	D E	F G	н			
4. Lot No, Recorded Plan 5. Private Claims					2	6	5	4	3	2	- -	
			1999		3 -	7	'8	9	10	- 33	12	
t, MARINUS MULDER do hereby certify that under requirements 1 and 2 above were in contract of suppley instruc-	th.	regulations and futes	[[[CIDIO.U	∧f landi	5	18	17	16	15	14	13	
lines 1 and 2 above to instruc	tions of the United	or that the corner point	s mentioned in lines	3,4 and 5	7 8	19	20	21	22	23	24	
current manual of survey instruction of a decree of a above were in conformance with Court of Law; established, expressed below:	the rules of the large re-established, in	Michigan Board of Edition nonumented, re-monum	nented, recovered,	found as	9	30	29	28	27	26	25	
NOTE: Not more than 4 corners, on this certificate.	, all in the same tow	m and range, may be recor	iled		11 12	31	32	33	34	35	36	
PERPETUATION: D.C. CRAWFORD 1883 RECORDED IN VOLUME 1, F CRAWFORD PERFORMED A SURY AND STONE FOR K-3. D.C. CRAWFORD FORMER IONIA	VEY IN SECTION 2 /	APRIL 26 & 27, 1889 REC	ORDED IN'VOLUME 2	2, PAGE 30 OF	: COU	NTY SU	JRVEY R	ECORUS	5. HE 51	.ppraxi	IMATELY	
24" LONG FOR THE CORNER IN CORNER LAWLESS HOUSE N 43	1/2° W 152 LINKS	(100.32 FEET); 9" HICKO	RA 2 14 115. E 191 r	E 61, CRAWF(INKS (99.66)	JRU H FEET)	1A5 MA I.	'WOWAL	. 1111112				
THE IONIA COUNTY ROAD COM		WARRED TODI 2 IN THE V	MITNESS INDEX SHE	ETS AS FOLL	OWS:	"1952'	" N.E. CI	ORNER I	1EADW#	ALL ON		
B. Description of comer evidence ONLY ONE WITNESS FROM THE BE ASCERTAINED. THERE STI 1891 CALLED FOR THE SOUTH WERE MEASURED. EXCAVATI	e found and/or method IE ROAD COMMISSI ILL IS A FARM HOU! HEAST CORNER OF ED THE ROAD TO A	l applied in restoring or reesta ION STILL STANDS BEING SE AT THE NORTHWEST I A HOUSE. NO STEEL OBJ DEPTH OF 48" BUT FOUI	ablishing corner: IS THE POWER POLE N CORNER OF THE ROA JECT COULD BE LOCA NO NO EVIDENCE. ES	JORTHEAST T AD INTERSEC ATED IN THE STABLISHED	THE H TION INTEF THE P	EADWA WITH A RSECTIO	ILL IS CI A STONE ON WHE IN OF K-	RUMBLE FOUND N THE V 3 BY TH	D AND I ATION VITNESS E 2 REN	NO COR CRAWF S DISTA MAINING	NER CAN ORD IN NCES	
C. Description of monument for SET A 7/8" X 30" STEEL ROD WITNESSED BY:	ICD DOLE MODTH 26	o fast 43,30 FEET		MONUMENT -	P.S. :	25863"	'IN A M	ONUME	MIROX			
NAIL & TAG WEST SIDE PUW SOUTHEAST CORNER HOUS! NAIL & TAG NORTHWEST SI TOP CENTERLINE OF C.M.P. 5/8" ROD & CAP #25863 WE	E FUUNDATION NO DE POWER POLE SC	OUTH 52° WEST 53.34 FE		FEET	ح."ح	3 ~9	· · ~					
5/8" ROD & CAP #25863 WE Signed by	:51 01) FILLIONE	mulele	Date	FORM APPROVED BY N				RVEYORS, JAK	1. 28, 1971		REVISED MAY	
				,							41 633143 <u>8</u>	

Surveyor's Michigan License No. 25863 Ratified by Peer Group P.A. 345 Ionia County Date September 23, 1999 Marinus A. Mulder, Chairman

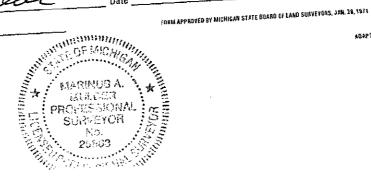

REVISED MAY 14, 1975 REVISED IAM, 1983 ADAPTED FOR WORD PROCESSING MARCH, 1993