

REMONUMENTATION CORNER

LAND CORNER RECORDATION CERTIFICATE
Filing Requirement of Act 74, Mich. P.A. 1970

For corners in


Ionia (County) Located In: Corner Code D-3

1. Public Land Survey	T <u>6N</u> R <u>6W</u>	<u>D-3</u>
	T _____ R _____	_____
	T _____ R _____	_____
	T _____ R _____	_____
2. Property Controlling in Section	S _____ T _____ R _____	_____
	S _____ T _____ R _____	_____
3. Miscellaneous Property in Sec.	S _____ T _____ R _____	_____
	S _____ T _____ R _____	_____

STATE OF MICHIGAN
 IONIA COUNTY
 RECEIVED FOR RECORD
 93 DEC 27 P1:12
 Oliver M. Okonko
 REGISTER OF DEEDS

Register of Deeds Stamp & File Number

4. Lot No. _____, Recorded Plat _____
 5. Private Claims _____

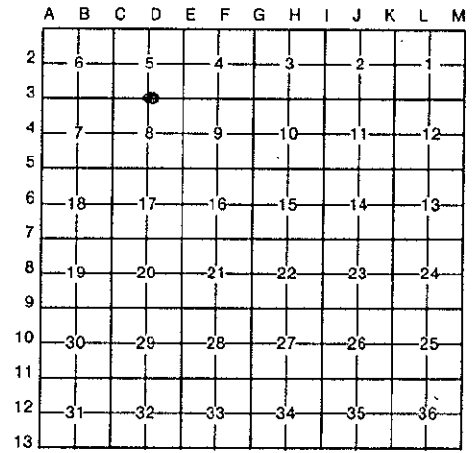

I, Marinus Mulder, in a field survey on August 30, 19 93, do hereby certify that under requirements of P.A. 74, Michigan P.A. of 1970, the corner points mentioned in lines 1 and 2 above were in conformance with regulations and rules therefore as required in the current manual of survey instructions of the United States Department of the Interior, Bureau of Land Management or by a decree of a Court of Law and/or that the corner points mentioned in lines 3, 4 and 5 above were in conformance with the rules of the Michigan Board of Land Surveyors or by a Decree of a Court of Law; established, re-established, monumented, re-monumented, recovered, found as expressed below:

NOTE: Not more than 4 corners, all in the same town and range, may be recorded on this certificate.

A. Description of original monument and accessories and/or subsequent restoration:

This corner was first set by U.S. Deputy Surveyor, Lucious Lyon.; who set a wood post witnessed by: (1) 9" Beech N 12° W 7 links (2) 13" Sycamore S 5° W 18 links. This was set in 1827.

Perpetuation: No information of this corner is found in the County Surveyors Volume. Highway plans located in the Road Commission for Kelsey Highway found in sheet 8 of 16 dated 1936 show witnesses for this corner. The plans state: Stone with wood stake on top & boat spike with the following witnesses: (1) Northeast corner church S56° W 71' (2) 40" Elm S 34° E 60.6' (3) Power pole Northeast 74.8'

B. Description of corner evidence found and/or method applied in restoring or reestablishing corner:

On surface of paved road found nail & tag. Excavated and found boat spike and remains of wood stake set on top of large pointed stone. 13" from surface. Witness to church corner is good. Left stone and set a fiberglass monument with a 4" diameter bronze cap over point of stone.

C. Description of monument for corner and accessories established to perpetuate locating the position of the corner:

Set fiberglass monument and 4" diameter bronze cap on top of pointed stone. 4" bronze cap stamped "Ionia County Survey Monument - do not disturb" with the following witnesses:

- Northeast corner of 31 1/2" x 51 3/4" wall which connects front steps to church S 62° W 65.96' (LeValley Church)
- Nail & tag East side 6" fence post N 28° W 63.28'
- Southwest Corner of former school house N 55° E 110.13'
- Top center of right of way monument S 62° E 64.31'

Signed by Marinus Mulder Date September 20, 1993
 Surveyor's Michigan License No. 25863