

**SURVEY & REMONUMENTATION**

JAN 20 1999

**LAND CORNER RECORDATION CERTIFICATE**  
 Filing Requirement of Act 74, Mich. P.A. 1970

LIBER 4 PAGE 46

SECTION

For corners in IONIA (County) Located in: Corner Code #

1. Public Land Survey T6 N R6 W M-8  
 T R  
 T R  
 T R

2. Property Controlling S T R  
 in Section S T R

3. Miscellaneous S T R  
 Property in Sec. S T R

4. Lot No. \_\_\_\_\_, Recorded Plat \_\_\_\_\_

5. Private Claims \_\_\_\_\_

STATE OF MICHIGAN  
 IONIA COUNTY  
 RECEIVED FOR RECORD  
 25 NOV 98 2:53 P.M.  
 DORIS M. ADAMS  
 REGISTER OF DEEDS  
**Register of Deeds Stamp & File Number**

	A	B	C	D	E	F	G	H	I	J	K	L	M
1													
2	6	5	4	3	2	1							
3													
4	7	8	9	10	11	12							
5													
6	18	17	16	15	14	13							
7													
8	19	20	21	22	23	24							
9													
10	30	29	28	27	26	25							
11													
12	31	32	33	34	35	36							
13													

I, MARINUS MULDER, in a field survey on JUNE 23 1998, do hereby certify that under requirements of P.A. 74, Michigan P.A. of 1970, the corner points mentioned in lines 1 and 2 above were in conformance with regulations and rules therefore as required in the current manual of survey instructions of the United States Department of the Interior, Bureau of Land Management or by a decree of a Court of Law and/or that the corner points mentioned in lines 3, 4 and 5 above were in conformance with the rules of the Michigan Board of Land Surveyors or by a Decree of a Court of Law; established, re-established, monumented, re-monumented, recovered, found as expressed below:

**NOTE:** Not more than 4 corners, all in the same town and range, may be recorded on this certificate.

A. Description of original monument and accessories and/or subsequent restoration:  
 THIS CORNER WAS FIRST ESTABLISHED BY U.S. DEPUTY SURVEYOR LUCIUS LYON IN 1827. A WOOD POST WAS SET WITNESSED BY A 28" BLACK ASH S 65° W 37 LINKS AND A 15" BEECH N 55° W 34 LINKS.

PERPETUATION: THERE IS NO RECORDED INFORMATION FOR M-8 IN THE COUNTY SURVEYORS RECORDS.

THE IONIA COUNTY ROAD COMMISSION IMPROVED AND PAVED KEEFER HIGHWAY IN 1963. NO INFORMATION WAS GIVEN FOR M-8 ON THE COUNTY ROAD PLANS.


B. Description of corner evidence found and/or method applied in restoring or reestablishing corner:  
 AT THE LOCATION OF M-8 EXCAVATED THE ROADBED OPPOSITE A FENCE LINE WEST AND FOUND 4 MEDIUM SIZE STONES WITH BROKEN CROCKERY AT A DEPTH OF 30". ACCEPTED THE EXISTING MONUMENTATION AS THE PERPETUATED CORNER.

C. Description of monument for corner and accessories established to perpetuate locating the position of the corner:  
 A 7/8" DIAMETER STEEL ROD 24" LONG WITH A 4" DIAMETER ALUMINUM CAP STAMPED "IONIA COUNTY-P.S. 25863" WAS SET IN PLACE OF THE EXISTING MONUMENTATION, WITNESSED BY:

- NAIL & TAG SOUTH SIDE 36" WALNUT WEST 29.96 FEET
- NAIL & TAG SOUTHEAST SIDE 18" WALNUT S 40° W 40.80 FEET
- NAIL & TAG EAST SIDE 10" TRIPLE BASSWOOD N 39° W 42.64 FEET
- NAIL & TAG EAST SIDE 12" WHITE ASH N 18° W 60.42 FEET
- 7/8" ROD WITH 4" DIAMETER CAP (A-8 T6N-R5W) NORTH 3.33 FEET

Ratified by Peer Group  
 P.A. 345 Ionia County

Date 8-19-98  
 Marinus A. Mulder, Chairman

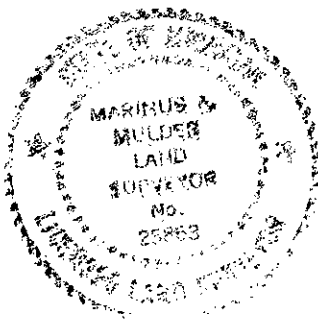

Signed by Marinus A. Mulder  
 Surveyor's Michigan License No. 25863

Date 11-11-98