

DEC 02 1997

COMMISSION

LAND CORNER RECORDATION CERTIFICATE
Filing Requirement of Act 74, Mich. P.A. 1970

LIBER 003 PAGE 359

For corners in IONIA Located In: _____ Corner Code # _____
(County)

1. Public Land Survey T6 N R7 W F-9 _____
T _____ R _____
T _____ R _____
T _____ R _____

2. Property Controlling in Section S _____ T _____ R _____
S _____ T _____ R _____

3. Miscellaneous Property in Sec. S _____ T _____ R _____
S _____ T _____ R _____

4. Lot No. _____, Recorded Plat _____

5. Private Claims _____

STATE OF MICHIGAN
IONIA COUNTY
RECEIVED FOR RECORD

12 NOV 97 3:55 P.M.

DIANE H. ADAMS
REGISTER OF DEEDS

Register of Deeds Stamp & File Number

	A	B	C	D	E	F	G	H	I	J	K	L	M
1													
2	6	5	4	3	2	1							
3													
4	7	8	9	10	11	12							
5													
6	18	17	16	15	14	13							
7													
8	19	20	21	22	23	24							
9													
10	30	29	28	27	26	25							
11													
12	31	32	33	34	35	36							
13													

I, MARINUS MULDER, in a field survey on JUNE 13 1997, do hereby certify that under requirements of P.A. 74, Michigan P.A. of 1970, the corner points mentioned in lines 1 and 2 above were in conformance with regulations and rules therefore as required in the current manual of survey instructions of the United States Department of the Interior, Bureau of Land Management or by a decree of a Court of Law and/or that the corner points mentioned in lines 3, 4 and 5 above were in conformance with the rules of the Michigan Board of Land Surveyors or by a Decree of a Court of Law; established, re-established, monumented, re-monumented, recovered, found as expressed below:

NOTE: Not more than 4 corners, all in the same town and range, may be recorded on this certificate.

A. Description of original monument and accessories and/or subsequent restoration:
THIS CORNER WAS ESTABLISHED BY U.S. DEPUTY SURVEYOR JOHN MULLETT IN 1831. A WOOD POST WAS SET WITNESSED BY A 16" SUGAR MAPLE N 12° W 31 LINKS AND A 8" SUGAR MAPLE S 1° E 13 LINKS.

PERPETUATION: THERE ARE NO RECORDED SURVEYS BY THE IONIA COUNTY SURVEYOR FOR F-9.

FORMER STATE HIGHWAY U.S. 16 CROSSES THIS CORNER IN AN EAST-WEST DIRECTION. THIS HIGHWAY WAS CONSTRUCTED IN 1928. THE IONIA COUNTY ROAD COMMISSION DOES NOT HAVE ANY WITNESSES FOR F-9. THE MICHIGAN DEPARTMENT OF TRANSPORTATION DOES NOT HAVE WITNESS INFORMATION FOR F-9.

B. Description of corner evidence found and/or method applied in restoring or reestablishing corner:

AT THE POSITION OF F-9 THERE IS A FENCE LINE RUNNING NORTH AND SOUTH. NO EVIDENCE IN THE PAVEMENT OF A MONUMENT WAS VISIBLE. RAN LINE BETWEEN E-9 AND G-9 AND SET A POINT OPPOSITE THE FENCE LINES. EXCAVATED THE ROAD THRU 8" OF BITUMINOUS TO THE OLD CONCRETE ROAD SURFACE BUT FOUND NO CORNER EVIDENCE. ESTABLISHED F-9 ON LINE BETWEEN E-9 AND G-9 AND OPPOSITE THE EXISTING FENCE LINES. MEASURED WEST TO E-9 2623.28 FEET. MEASURED EAST TO G-9 2618.87 FEET.


C. Description of monument for corner and accessories established to perpetuate locating the position of the corner:
SET A 7/8" STEEL ROD WITH A 4" DIAMETER CAP STAMPED "IONIA COUNTY 25863" WITNESSED BY:

- NAIL & TAG EAST SIDE 8" ASH SOUTH 42.95 FEET
- NAIL & TAG EAST SIDE 8" ASH S 20° E 38.00 FEET
- NAIL & TAG EAST SIDE 8" ASH S 39° W 34.05 FEET
- NAIL & TAG EAST SIDE 26" ASH NORTH 90.74 FEET

Ratified by Peer Group
P.A. 345 Ionia County

Date 9-24-97

Marinus A. Mulder, Chairman

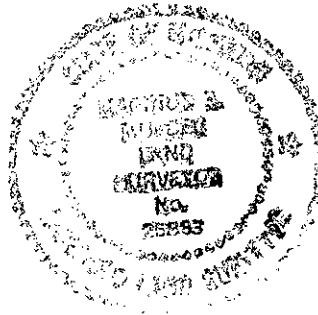

Signed by Marinus A. Mulder Date 9-26-97
Surveyor's Michigan License No. 25863