

STATE OF MICHIGAN
DEPARTMENT
OF
NATURAL RESOURCES

LAND CORNER RECORD

3-D

Berlin Twp.

IONIA COUNTY

T 6N R 7W

DESCRIPTION OF CORNER

SOUTH 1/4 CORNER SECTION 5

CORNER MONUMENT


FOUND BOAT SPIKE

DATE MONUMENT PLACED AND WITNESSED

APRIL 27, 1971

WITNESSES TO CORNER.....

S 68°E 92.12' TELEPHONE POLE

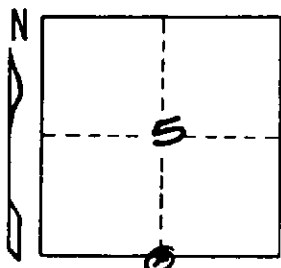

CIRCLE CORNER REGISTERED


S 70°W 66.10' TELEPHONE POLE

NORTH 32.8' FENCE COR. POST

AND

N 22°E 53.0' SE COR. OF SHED
(16' x 20')

DESCRIPTION IN DETAIL AS TO HOW CORNER WAS LOCATED AND IDENTIFIED OR RESTORED.

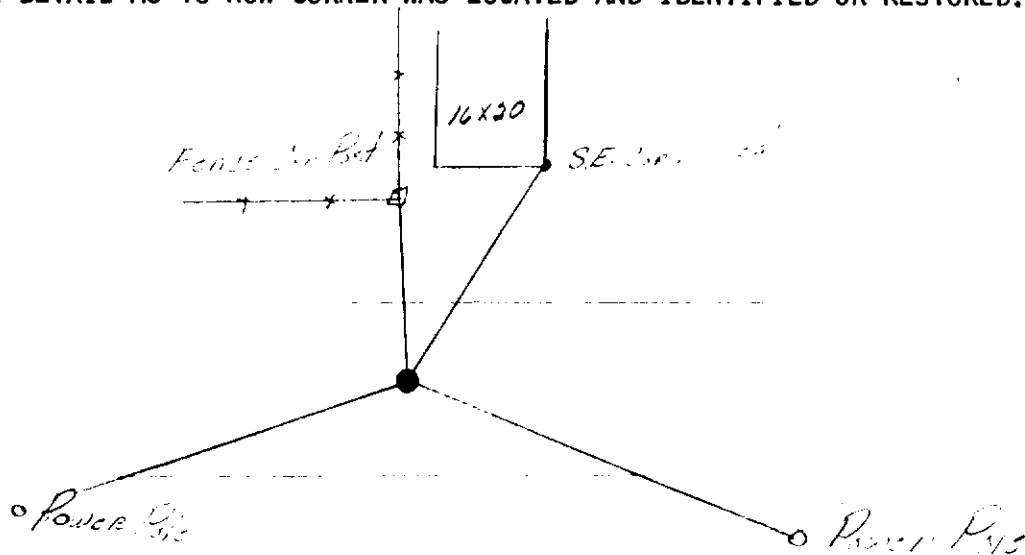

SURVEYOR'S SEAL

SIGNED

REGISTERED LAND SURVEYOR

DATE

DISTRIBUTION:

County Courthouse
Area Forester (Regions I & II)
District or Region Surveyor
Forestry Div., Lansing

R 4047
Rev. 10/68