 
T 6 N - R 7 W