


T 6 N, R 8 W
 (FROM ROAD COMMISSION)

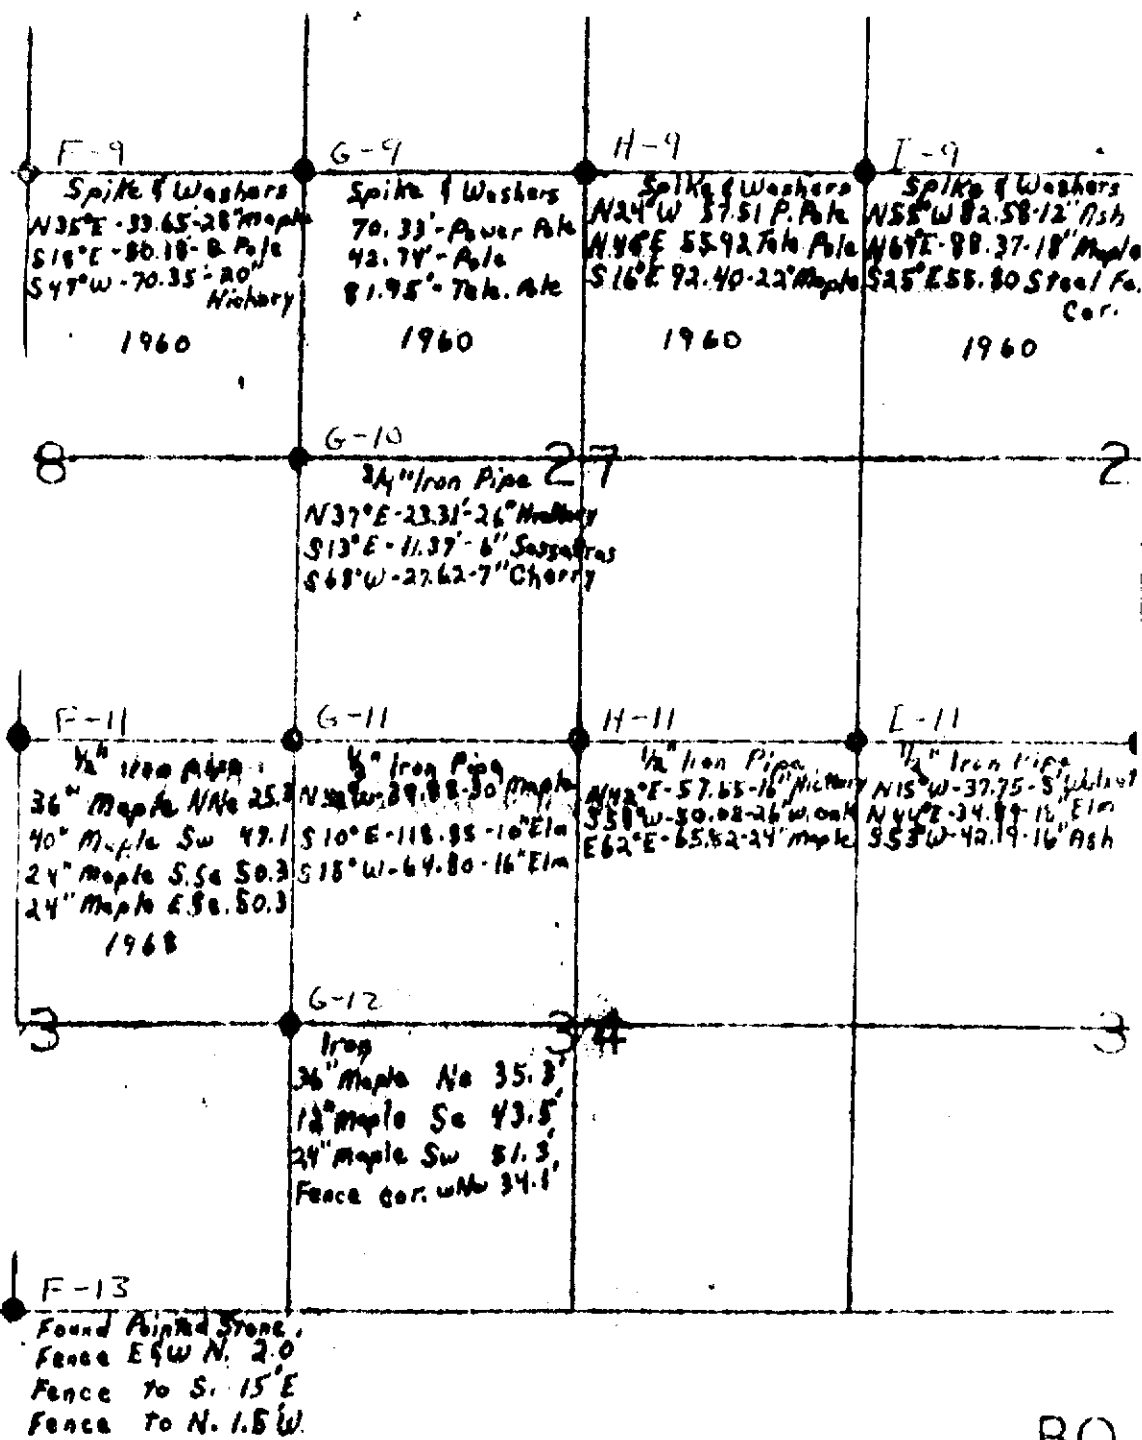

BO