

DEC 20 2000

LAND CORNER RECORDATION CERTIFICATE
Filing Requirement of Act 74, Mich. P.A. 1970

SECTION

For corners in
IONIA
(County)

Located In:


Corner Code #



LIBER 4

PAGE 156

- 1. Public Land Survey T7 N R6 W D-1
T R
T R
T R
- 2. Property Controlling S T R
in Section S T R
- 3. Miscellaneous S T R
Property in Sec. S T R
- 4. Lot No. _____, Recorded Plat _____
- 5. Private Claims _____

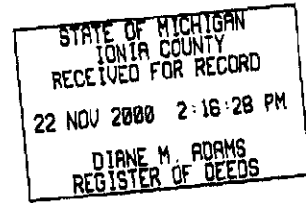

Register of Deeds Stamp & File Number

	A	B	C	D	E	F	G	H	I	J	K	L	M
1													
2	6	5	4	3	2	1							
3													
4	7	8	9	10	11	12							
5													
6	18	17	16	15	14	13							
7													
8	19	20	21	22	23	24							
9													
10	30	29	28	27	26	25							
11													
12	31	32	33	34	35	36							
13													

I, MARINUS MULDER, in a field survey on JULY 6, 2000, do hereby certify that under requirements of P.A. 74, Michigan P.A. of 1970, the corner points mentioned in lines 1 and 2 above were in conformance with regulations and rules therefore as required in the current manual of survey instructions of the United States Department of the Interior, Bureau of Land Management or by a decree of a Court of Law and/or that the corner points mentioned in lines 3, 4 and 5 above were in conformance with the rules of the Michigan Board of Land Surveyors or by a Decree of a Court of Law; established, re-established, monumented, re-monumented, recovered, found as expressed below:

NOTE: Not more than 4 corners, all in the same town and range, may be recorded on this certificate.

A. Description of original monument and accessories and/or subsequent restoration:
THIS CORNER WAS NOT ESTABLISHED BY U.S. GOVERNMENT SURVEYORS.

PERPETUATION: THERE IS NO RECORDED COUNTY SURVEY INFORMATION FOR THIS CORNER.

THE IONIA COUNTY ROAD COMMISSION IMPROVED AND PAVED NICKLE PLATE HIGHWAY IN 1959. THE ROAD PLANS HAVE NO SHEET NUMBER. THE ONLY REFERENCE TO THE CORNER IS THAT D-1 IS 107 FEET EAST OF D-13, T8N-R6W.

THE IONIA COUNTY ROAD COMMISSION HAS NO WITNESSES FOR D-1 IN THE WITNESS INDEX SHEETS. REGISTERED LAND SURVEYOR RICHARD CRATER NO. 16924, RECORDED D-1 SEPTEMBER 1, 1972 FOUND IN LIBER 1, PAGE 47 OF ACT 74 RECORDS. CRATER FOUND A 1" IRON WITNESSED BY: 40" MAPLE N 50° E 63.4 FEET; TWIN 20" MAPLE SOUTH 33 FEET; TELEPHONE POLE S 30° E 60.00 FEET; SOUTH 1/4 CORNER SECTION 32 T8N-R6W WEST 106.60 FEET.

B. Description of corner evidence found and/or method applied in restoring or reestablishing corner:

ONE OF CRATER'S WITNESSES REMAINS BEING THE TWIN MAPLE. MEASURED 106.7 FEET EAST OF D-13, T8N-R6W AND FOUND A 3/8" X 14" BAR JUST BELOW THE SURFACE. BELOW THIS FOUND A 1" IRON BAR. NO OTHER EVIDENCE WAS FOUND. FENCE LINE RUNS SOUTH FROM RIGHT OF WAY LINE.

DISTANCE TO C-1 MEASURED 2641.51 FEET
DISTANCE TO E-1 MEASURED 2644.13 FEET

D-1 IS LOCATED IN THE PHYSICAL CENTERLINE OF THE ROAD, AND IS ON THE TOWNSHIP LINE.

C. Description of monument for corner and accessories established to perpetuate locating the position of the corner:
REPLACED EXISTING MONUMENTATION WITH A 7/8"x24" STEEL ROD WITH A 4" DIAMETER ALUMINUM CAP STAMPED - "IONIA COUNTY - P.S. 25863"
WITNESSED BY:

- NAIL & TAG NORTH SIDE 14" TWIN ELM N 60° W 51.58 FEET
- NAIL & TAG NORTH SIDE 22" ELM S 71° W 39.02 FEET
- NAIL & TAG EAST SIDE 24" TWIN MAPLE S 5° E 32.29 FEET
- NAIL & TAG SOUTH SIDE 24" ELM N 42° W 32.30 FEET
- S 1/4 CORNER SEC. 32 T8N-R6W, D-13, 7/8" ROD AND 4" CAP WEST 106.67 FEET

Signed by Marinus A. Mulder Date 11-8-00

Surveyor's Michigan License No. 25863



FORM APPROVED BY MICHIGAN STATE BOARD OF LAND SURVEYORS, JAN. 28, 1971

REVISED MAY 14, 1975
REVISED JAN. 1983
ADAPTED FOR WORD PROCESSING MARCH, 1987

Ratified by Peer Group
P.A. 345 Ionia County

Date 9-21-2000
Marinus A. Mulder, Chairman