[redacted]VEY &
REMONUMENTATION

OCT 1 1 1994

COMMISSION

REMONUMENTATION CORNER

**LAND CORNER RECORDATION CERTIFICATE**
**Filing Requirement of Act 74, Mich. P.A. 1970**

STATE OF MICHIGAN
IONIA COUNTY
RECEIVED FOR RECORD
94 JUN -6 P 3:52
Diane M. Robinson
REGISTER OF DEEDS

For corners in

Ionia
(County)

| | Located In: | Corner Code ## |
|---|---|---|
| 1. Public Land Survey | T 7N R 8W | H-12 |
| | T ___ R ___ | |
| | T ___ R ___ | |
| | T ___ R ___ | |
| 2. Property Controlling | S ___ T ___ R ___ | |
| in Section | S ___ T ___ R ___ | |
| 3. Miscellaneous | S ___ T ___ R ___ | |
| Property in Sec. | S ___ T ___ R ___ | |

**Register of Deeds Stamp & File Number**

4. Lot No. _____ , Recorded Plat _____
5. Private Claims _____

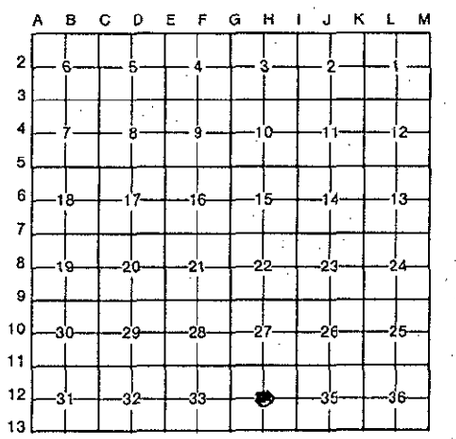


I, Marinus Mulder, in a field survey on November 4, 19 93, do hereby certify that under requirements of P.A. 74, Michigan P.A. of 1970, the corner points mentioned in lines 1 and 2 above were in conformance with regulations and rules therefore as required in the current manual of survey instructions of the United States Department of the Interior, Bureau of Land Management or by a decree of a Court of Law and/or that the corner points mentioned in lines 3, 4 and 5 above were in conformance with the rules of the Michigan Board of Land Surveyors or by a Decree of a Court of Law; established, re-established, monumented, re-monumented, recovered, found as expressed below:

**NOTE: Not more than 4 corners, all in the same town and range, may be recorded on this certificate.**

A. Description of original monument and accessories and/or subsequent restoration:

This corner (center of Section) was not set by G.L.O. Surveyors.
There is no county survey information on this corner.

B. Description of corner evidence found and/or method applied in restoring or reestablishing corner:

Intersected North-South and East-West 1/4 lines and established center of section.

C. Description of monument for corner and accessories established to perpetuate locating the position of the corner:

Set 3/4" x 36" steel rod with a 2 3/4" diameter cap stamped "P.S. 25863"
Witnessed by:
Nail & tag East side 24" Oak N 9° W 25.90'
Nail & tag North side 20" Oak East 15.77'
Nail & tag East side 10" Hickory S 39° W 9.74'
Nail & tag South side 8" Maple N 67° W 14.16'
Falls in tree line running South, East & West.

Ratified by Peer Group
P.A. 345 Ionia County

Date 4-20-94 m.a.m.
Marinus A. Mulder, Chairman

Signed by Marinus A. Mulder Date April 29, 1994

Surveyor's Michigan License No. 25863

FORM APPROVED BY MICHIGAN STATE BOARD OF LAND SURVEYORS, JAN. 28, 1971
REVISED MAY 14, 1975
REVISED JAN., 1983