
SURVEY & REMONUMENTATION

SEP 07 1999

REMONUMENTATION CORNER

	LAND CORNI	ER RECORDATION CERTI	IFICATE			
SECTION	Filing Requir	ement of Act 74, Mich. P.	.A. 1970	~~	76.	٦٠
For carners in				<u> </u>	4	TET COS COST TET
Ionia (County)	Located In:	Corner Code ##		PEGISTER OF		
				म्री भू	4-6	- ;> € *10
Public Land Survey	т <u>7N_ я 8W_</u>	<u>I-11</u>		9.	6	e 3
•	T R			000 m	70	
	T R		•		w ••	4 1 1 1 1 1 1 1 1 1 1 1 1 1 1 1 1 1 1 1
2 Property Controlling S	T R T R			•	ن	
· · ·	TR	,				
	T R	ı	Davistan of	Danada Ota	- 0 Ell.	N 1 b
	TR		Hegister of	Deeds Stamp) & File	Number
4. Lot No, Records 5. Private Claims			A B	CDEF	G H	I J K L
o. Theate Olamis			2 — 6-		\$	 - -
			3			
•			4 /-			1 1 12-
I, <u>Marinus Mulder</u> , in a	field survey onOcto	ber 6 19 93	5			
do hereby certify that under requireme	ents of P.A. 74, Michigan P.A	. of 1970, the corner points menti-	oned 6		15-	
in lines 1 and 2 above were in confo					T ï	
current manual of survey instructions Management or by a decree of a Court			Lanu			
above were in conformance with the rules of the Michigan Board of Land Surveyors or by a Decree of a			eofa o	20-21-	12-	23-1-24
Court of Law, established, re-established, monumented, re-monumented, recovered, found as			id as	- - - - - - - - - - 		
expressed below:			1030	2928	27	1-26-1-25-
on this certificate.			1 1	- - - - - - - - - - 	+	•
			12 -31	32 33	3'4	35 36
A. Description of original monun	nent and accessories an	d/or subsequent restoration	13	- 1 - 1 - 1 -		
1837. A wood post was 10" White Oak N 11° E 7 Perpetuation: A.C. Sm: Section 26, T7N-R8W and Remains of the G.L.O. I set. The witnesses wer S 27 1/2° W 66 links. marginal notation in the found the corner in 190 B. Description of corner evidence. One of A.C. Smith's 1 links Southeast. The About 16" below the second. Accepted this center.	78 links. ith former Ionia d "reset the Sout bearing trees wer re i2" White Oak D.C. Crawford fo he County Surveyo O3 and 1911. Cont- ce found and/or method e witness distance surface stones. c	County Surveyor per hwest section corne re still there. He is \$51° E 67 1/4 link ormer Ionia County Sors copy of the G.L. applied in restoring or reestant applied in restoring or reestant to the was measured and the rockery, glass and prockery, glass and prockery.	formed work r" April 30t did not say s and a 5" W arveyor made O. notes tha ablishing corner: g the White (the road exceptates of tip	in h 1875. what he hite Oak a t he Oak 67 1/4 avated.	1	
		,	•			
	·	·	•			
	•		-			
5		·				
water the state of					-	
C. Description of monument for	corner and accessories	established to perpetuate to	ocating the position	n of the com	er:	
		;	·			
Set 3/4" x 24" steel Witnessed by: Nail & tag East side Nail & tag Northeast Nail & tag Northwest Nail & tag West side Wickham's recorded pi	54" Oak N 27° W 4 side 42" Oak S 45 side 50" Oak stur 48" Oak S 8° E 75	49.15' 5' E 45.58' (Smith's np S 58' W 42.83 fee 9.84'	s 1875 witnes et	e (1798) d P.A. 346	sinci d	eer Group County
	•					
/	,			Marinus A	. Mulde	er, Chairman
Signed by Maris	a mulde	Date	April 29, 199)4		
	25062					
Surveyor's Michigan License No.	43603		FORM APPROVED BY MIC	HIGAN STATE BOARD O		VEYORS, JAN. 28, 1: REVISED MAY 14, 1:

Continued from A: Professional Surveyor Burt Wickham Jr. No. 17639 recorded I-11 on September 15, 1987 found in Liber 2 page 282. Wickham stated there was no evidence of original corner or accessories found, and goes on to say he found a 1" iron pipe in centerline x of roads.

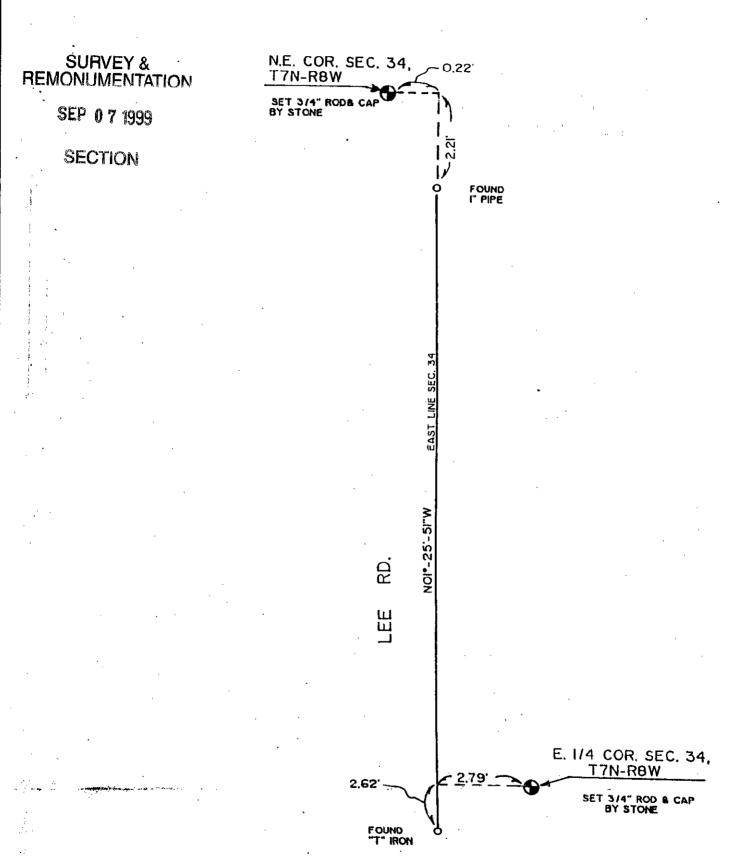

Car strain